

National Grid SA-CO **PRODUCTION FILE**

Contractor : ABB Contracting Co.

Project : SS 8709- 132/13.8kV in Alkha

Contract No : 11131113/00

Substation : 8709

**Subject : 132Kv Busbar Protection Set-
Relay Panel-4**





POWER SYSTEMS NETWORK MANAGEMENT
PROTECTION AND SUBSTATION AUTOMATION SYSTEMS
WBS NO: S-13656

ABB AUTOMATION COMPANY LTD.
414, AL-KHARJ ROAD
SECOND INDUSTRIAL CITY
RIYADH-11383 K.S.A

CONTRACTOR : ABB Contracting Company
CLIENT : National Gridsa
PROJECT : CONSTRUCTION OF NEW 132/13.8kV SS 8709 IN AL-KHARJ CITY
SUBSTATION : S/S 8709
CONTRACT NO. : 11131113/00
TITLE : Assembly Drawing - +BBP2-4
[132KV BUSBAR PROTECTION MAIN-2 BAY UNIT PANEL]

AS-BUILT BY _____ DATE _____ CONTRACT NO. 11131113/00 JOB ORDER NO. S-13656

01	13 49	FACTORY ASBUILT	DRAWN BY RIZ	CHECKED BY KVR
00	13 05	FOR APPROVAL	DATE STARTED 31.01.2013	DATE COMPLETED _____
REV. NO.	DATE	DESCRIPTION	OPRG. DEPT. CTPD	ENG. DEPT. AUT-PSAC

COVER SHEET

132KV BUSBAR PROTN.MAIN-2 BU PANEL +BBP2-4
S/S 8709 - 132/13.8KV IN AL-KHARJ CITY
RIYADH SAUDI ARABIA


الشركة الوطنية لنقل الكهرباء



INDEX	PLANT NO.	DRAWING NUMBER	SHEET NO.	REV. NO.
-	C421	CD-323006	SHT 001	01

NG/D2-D (2012/01)

DMS VECTOR NGD200

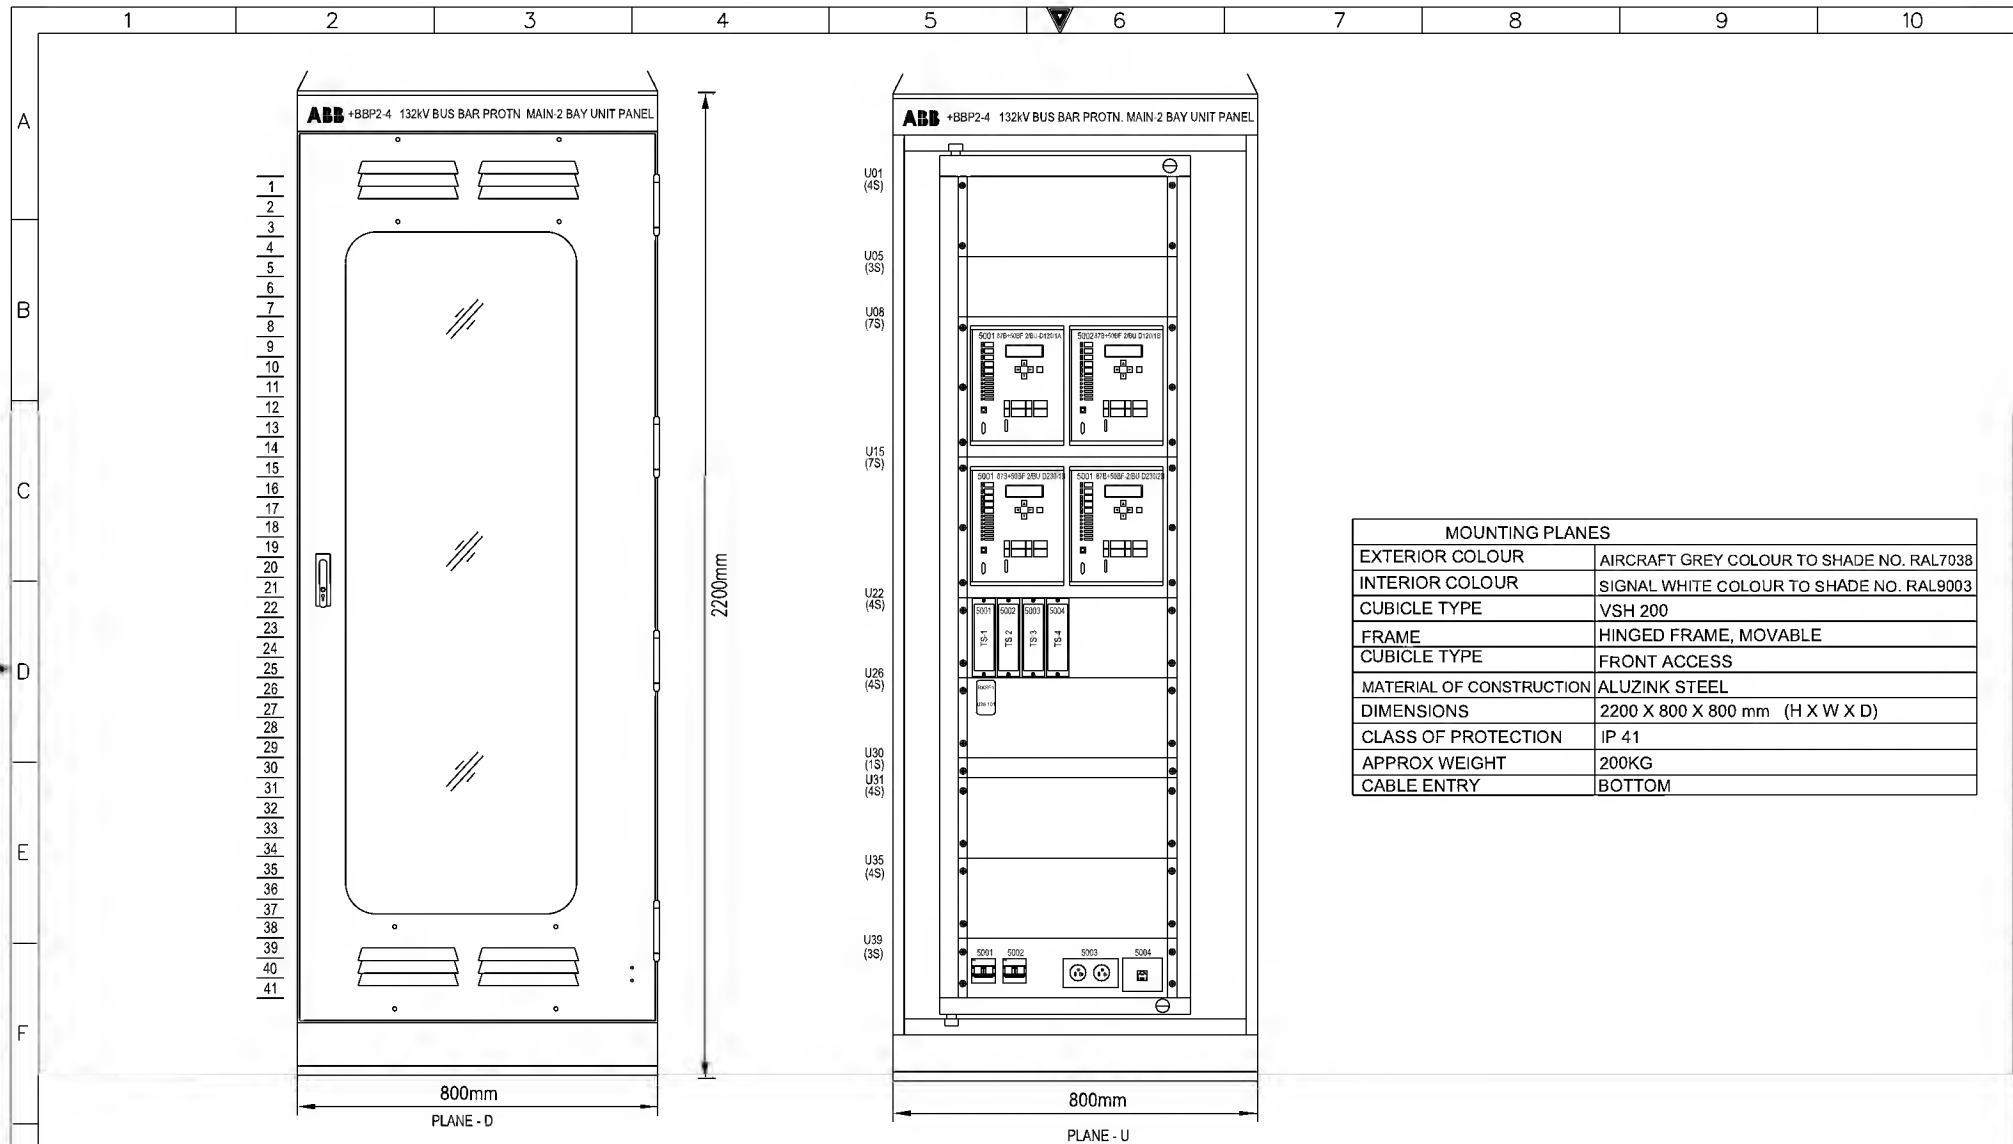


MOUNTING PLANES	
EXTERIOR COLOUR	AIRCRAFT GREY COLOUR TO SHADE NO. RAL7038
INTERIOR COLOUR	SIGNAL WHITE COLOUR TO SHADE NO. RAL9003
CUBICLE TYPE	VSH 200
FRAME	HINGED FRAME, MOVABLE
CUBICLE TYPE	FRONT ACCESS
MATERIAL OF CONSTRUCTION	ALUZINK STEEL
DIMENSIONS	2200 X 800 X 800 mm (H X W X D)
CLASS OF PROTECTION	IP 41
APPROX WEIGHT	200KG
CABLE ENTRY	BOTTOM

AS-BUILT BY _____ DATE _____		CONTRACT NO. 1113113/00	JOB ORDER NO. S-13656	ASSEMBLY DRAWING		الشركة الوطنية لنقل الكهرباء		نقل الكهرباء	
01	13 49	FACTORY ASBUILT		DRAWN BY RIZ	CHECKED BY KVR	132KV BUSBAR PROTN.MAIN-2 BU PANEL +BBP2-4		National Grid sa	
00	13 05	FOR APPROVAL		DATE STARTED 31.01.2013 DATE COMPLETED _____		S/S 8709 - 132/13.8KV IN AL-KHARJ CITY		INDEX	
REV. NO.	DATE	DESCRIPTION		OPRG. DEPT. CTPD	ENG. DEPT. AUT-PSAC	RIYADH SAUDI ARABIA		PLANT NO.	DRAWING NUMBER
								C421	CD-323006
								SHEET NO.	REV. NO.
								001/002	01


NG/D2-D (2012/01)
DMS VECTOR NGD200

THIS DRAWING AND THE INFORMATION CONTAINED HEREIN ARE THE SOLE PROPERTY OF National Grid sa. NO REPRODUCTION IN FULL OR IN PART SHALL BE OBTAINED FROM THIS DOCUMENT WITHOUT THE WRITTEN CONSENT OF ITS OWNER.

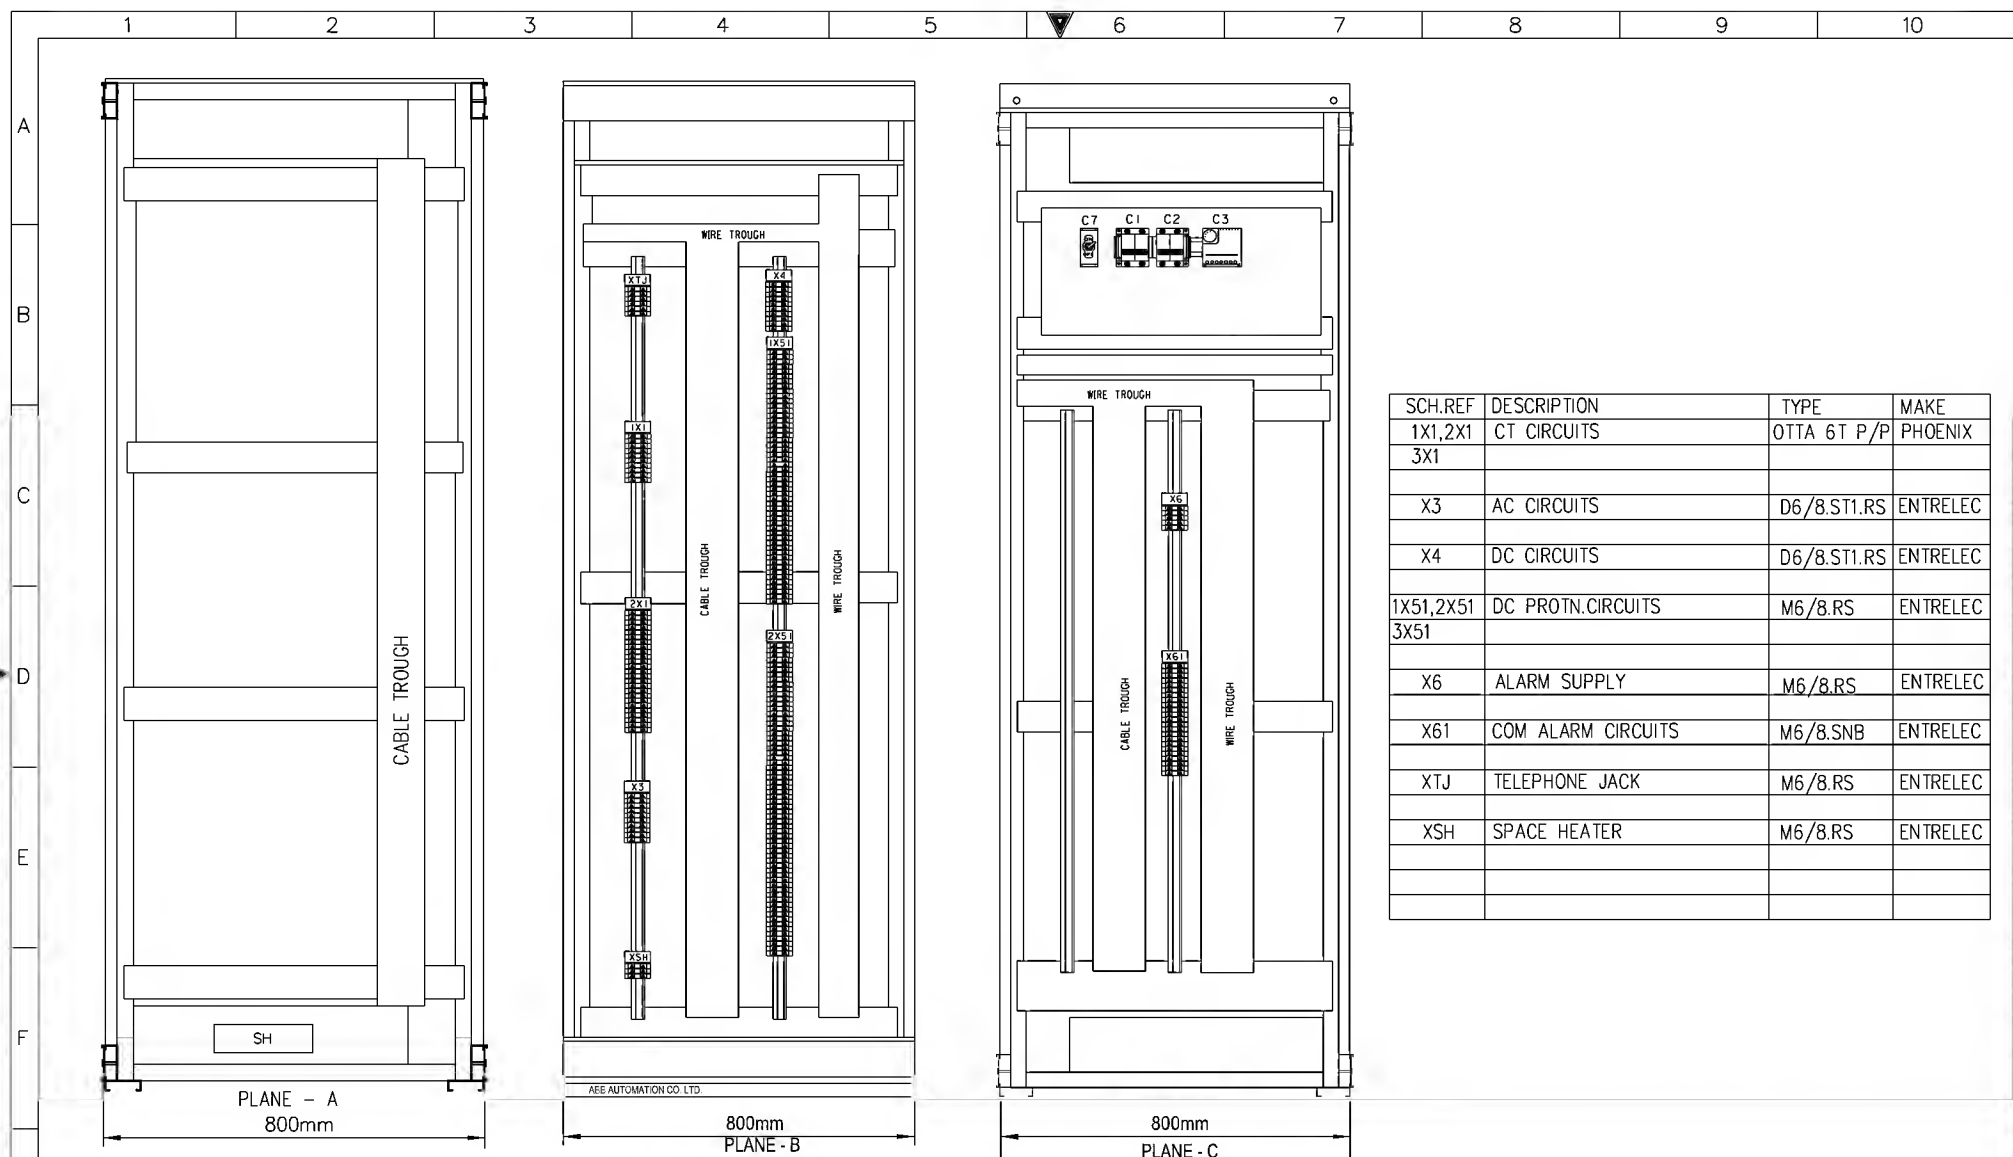

SCH.REF	DESCRIPTION	TYPE	MAKE
1X1,2X1 3X1	CT CIRCUITS	OTTA 6T P/P	PHOENIX
X3	AC CIRCUITS	D6/8.ST1.RS	ENTRELEC
X4	DC CIRCUITS	D6/8.ST1.RS	ENTRELEC
1X51,2X51 3X51	DC PROTN.CIRCUITS	M6/8.RS	ENTRELEC
X6	ALARM SUPPLY	M6/8.RS	ENTRELEC
X61	COM ALARM CIRCUITS	M6/8.SNB	ENTRELEC
XTJ	TELEPHONE JACK	M6/8.RS	ENTRELEC
XSH	SPACE HEATER	M6/8.RS	ENTRELEC

AS-BUILT BY _____ DATE _____		CONTRACT NO. 1113113/00	JOB ORDER NO. S-13656	ASSEMBLY DRAWING		الشركة الوطنية لنقل الكهرباء		نقل الكهرباء	
01	13 49	FACTORY ASBUILT		DRAWN BY RIZ	CHECKED BY KVR	132KV BUSBAR PROTN.MAIN-2 BU PANEL +BBP2-4		National Grid sa	
00	13 05	FOR APPROVAL		DATE STARTED 31.01.2013	DATE COMPLETED _____	S/S 8709 - 132/13.8KV IN AL-KHARJ CITY			
REV. NO.	DATE	DESCRIPTION		OPRG. DEPT. CTPD	ENG. DEPT. AUT-PSAC	RIYADH		SAUDI ARABIA	
						INDEX		PLANT NO.	
						DRAWING NUMBER		SHEET NO.	
						CD-323006		G02/G03	
						REV. NO.		01	

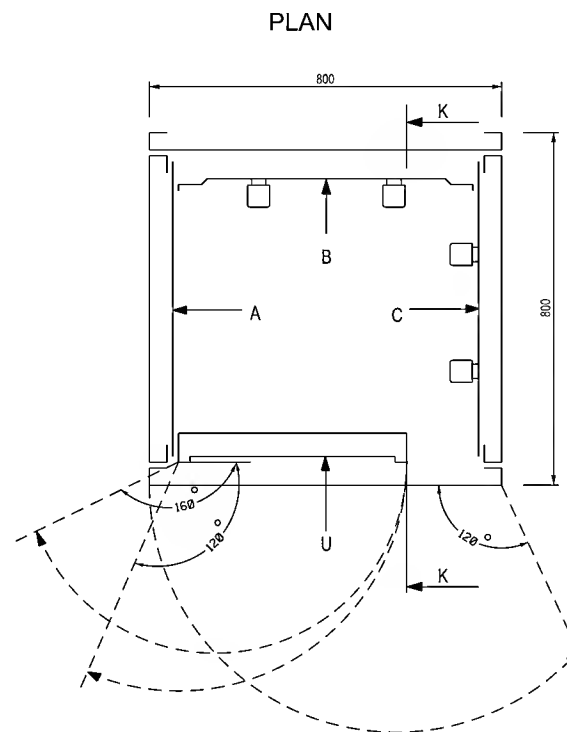

NG/D2-D (2012/01)

DMS	VECTOR	NGD200
-----	--------	--------

1 2 3 4 5 6 7 8 9 10

A

B

C

D

E


F

G




TOP VIEW FOR EARTHING BAR

U PLANE TOP LABEL

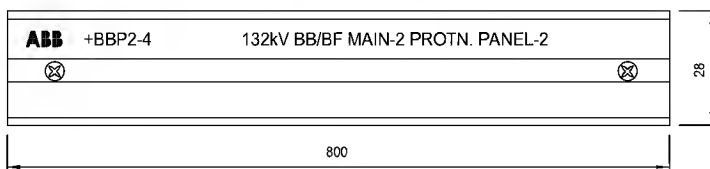

U PLANE BOTTOM LABEL

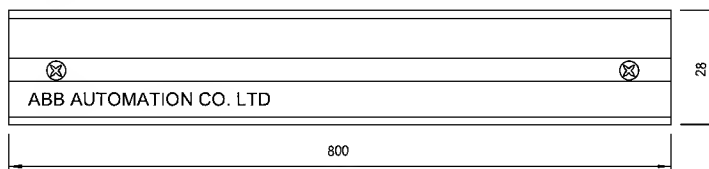

MANUFACTURING LABEL

ABB ABB Automation Co.Ltd.	
PROJECT :	National Grid SA S/S 8709
ORDER REFERENCE :	2875 RF S13656
YEAR OF MANUFACTURE:	2013
PANEL NO. :	+BBP2-4
DRAWING NO. :	S13656-CD-323007
MADE IN THE KINGDOM OF SAUDI ARABIA	

AS-BUILT BY _____ DATE _____ CONTRACT NO. 1113113/00 JOB ORDER NO. S-13656

01	13 49	FACTORY ASBUILT	DRAWN BY RIZ	CHECKED BY KVR
00	13 05	FOR APPROVAL	DATE STARTED 31.01.2013	DATE COMPLETED _____
REV. NO.	DATE	DESCRIPTION	OPRG. DEPT. CTPD	ENG. DEPT. AUT-PSAC

ASSEMBLY DRAWING

132KV BUSBAR PROTN.MAIN-2 BU PANEL +BBP2-4
S/S 8709 - 132/13.8KV IN AL-KHARJ CITY
RIYADH SAUDI ARABIA

الشركة الوطنية لنقل الكهرباء



نقل الكهرباء
National Grid sa

INDEX	PLANT NO.	DRAWING NUMBER	SHEET NO.	REV. NO.
-	C421	CD-323006	SHT CONT. G04 L00	01

NG/D2-D (2012/01)

DMS

VECTOR

NGD200



POWER SYSTEMS NETWORK MANAGEMENT
PROTECTION AND SUBSTATION AUTOMATION SYSTEMS
WBS NO: S-13656

ABB AUTOMATION COMPANY LTD
414, AL-KHARJ ROAD
SECOND INDUSTRIAL CITY
RIYADH-11383 K.S.A

CONTRACTOR : ABB Contracting Company
CLIENT : National Gridsa
PROJECT : CONSTRUCTION OF NEW 132/13.8kv SS 8709 IN AL-KHARJ CITY
SUBSTATION : S/S 8709
CONTRACT NO. : 11131113/00
TITLE : LIST OF APPARATUS - +BBP2-4
[132KV BUSBAR PROTECTION MAIN-2 BAY UNIT PANEL]

AS-BUILT BY _____ DATE _____ CONTRACT NO. 11131113/00 JOB ORDER NO. S-13656

01	13 49	FACTORY ASBUILT	DRAWN BY RIZ	CHECKED BY KVR
00	13 05	FOR APPROVAL	DATE STARTED 31.01.2013	DATE COMPLETED _____
REV. NO.	DATE	DESCRIPTION	OPRG. DEPT. CTPD	ENG. DEPT. AUT-PSAC

COVER SHEET

132KV BUSBAR PROTN.MAIN-2 BU PANEL +BBP2-4
S/S 8709 - 132/13.8KV IN AL-KHARJ CITY
RIYADH SAUDI ARABIA

الشركة الوطنية لنقل الكهرباء



نقل الكهرباء
National Grid sa

INDEX	PLANT NO.	DRAWING NUMBER	SHEET NO.	REV. NO.
-	C421	CD-323006	SHT CONT. L00 L01	01

NG/D2-D (2012/01)

DMS

VECTOR

NGD200

	1	2	3	4	5	6	7	8	9	10
A	SR. NO.	GA. REF.	SCH. REF.	DESCRIPTION		SHT.	QTY.	TYPE	MAKE	ORDERING INFORMATION
	1	U08.5001	87B+50BF-2/BU-D120/1A	RELAY CUBICLE- +BBP2-4 FOR 132KV BB/BF MAIN-2 ACCOMODATING THE FOLLOWING			4	VSH 200	ABB	
		U08.5002	87B+50BF-2/BU-D120/1B	BAY UNIT FOR NUMERICAL BUSBAR PROTECTION WITH FOLLOWING		293,294		7SS523	SIEMENS	7SS5231-5CA01+1AA1
		U15.5001	87B+50BF-2/BU-D230/1B	HIGH TROUGH-FAULT STABILITY EVEN IN CASE OF CT SATURATION.		295,296				
		U15.5001	87B+50BF-2/BU-D230/1B	NEUTRAL CURRENT CRITERION INSTANTANEOUS VALUES FOR FAULT RECORDING.		297,298				
		U15.5001	87B+50BF-2/BU-D230/2B	DISTURBANCE FREE AND FAST DATA TRANSFER TO & FROM CENTRAL UNIT		299,300				
				PHASE SEGRAGATED MEASUREMENT						
				REDUCE CT PERFORMANCE REQUIREMENTS						
				BUILT IN HUMAN MACHINE INTERFACE						
				BUILT IN BREAKER FAILURE FUNCTION.						
B				END FAULT PROTECTION FUNCTION						
				DISTURBANCE RECORDER						
				BINARY OUTPUT : 20						
				BINARY OUTPUT : 6+2-WD						
				FULLY NUMERICAL SIGNAL PROCESSING						
				RATED CURRENT : 1A						
				AUX. VOLTAGE : 60-250V DC						
				RATED FREQUENCY : 60HZ						
C	2	U22.5001	TS-1	TEST SWITCH FOR 87B+50BF-2/BU-D120/1A RELAY		293	4	MMLG02	ALSTOM	MMLG02 R1AA 0001D
		U22.5002	TS-2	TEST SWITCH FOR 87B+50BF-2/BU-D120/1B RELAY		295				
		U22.5003	TS-3	TEST SWITCH FOR 87B+50BF-2/BU-D230/1B RELAY		297				
		U22.5004	TS-4	TEST SWITCH FOR 87B+50BF-2/BU-D230/2B RELAY		299				
	3	U26.101	74BF-2/D120	DUAL TARGET RELAY FOR 87B+50BF-2/D120 AND 87B+50BF-2/D230 DC SUPERVISION		234	1	RXSF 1	ABB	RK 271 019-AN
			/74BF-2/D230	AUXILIARY VOLTAGE : 110-125V DC		239				
				CONTACT DATA : 1NO + 2NC						
				FLAG : SELF RESET,REVERSE						
D										
E										
F										

AS-BUILT BY _____ DATE _____		CONTRACT NO. 11131113/00		JOB ORDER NO. S-13656		LIST OF APPARATUS		نقل الكهرباء الشركة الوطنية لنقل الكهرباء National Grid sa	
01	13 49	FACTORY ASBUILT		DRAWN BY RIZ CHECKED BY KVR		132KV BUSBAR PROTN.MAIN-2 BU PANEL +BBP2-4		INDEX PLANT NO. DRAWING NUMBER SHEET NO. REV. NO. - C421 CD-323006 L01 L02 01	
00	13 05	FOR APPROVAL		DATE STARTED 31.01.2013 DATE COMPLETED _____		S/S 8709 - 132/13.8KV IN AL-KHARJ CITY		NG/D2-D (2012/01) NGD200	
REV. NO.	DATE	DESCRIPTION		OPRG. DEPT. CTPD ENG. DEPT. AUT-PSAC		RIYADH SAUDI ARABIA		DMS VECTOR	

THIS DRAWING AND THE INFORMATION CONTAINED HEREIN ARE THE SOLE PROPERTY OF National Grid sa. NO REPRODUCTION IN FULL OR IN PART SHALL BE OBTAINED FROM THIS DOCUMENT WITHOUT THE WRITTEN CONSENT OF ITS OWNER.

1 2 3 4 5 6 7 8 9 10

A

B

C

D

E

F

G

LABEL REF.	LABEL ENGRAVING	MATERIALS	ENGRAVING	LABEL SIZE	LETTER SIZE
UD8.5001	U08.5001 878+50BF-2/BU-D120/1A	TRAFOLITE	BLACK LETTERS ON WHITE BACKGROUND	50X15mm	4mm
U08.5002	U08.5002 878+50BF-2/BU-D120/1B	TRAFOLITE	BLACK LETTERS ON WHITE BACKGROUND	50X15mm	4mm
U15.5001	U15.5001 878+50BF-2/BU-D230/1B	TRAFOLITE	BLACK LETTERS ON WHITE BACKGROUND	50X15mm	4mm
U15.5002	U15.5002 878+50BF-2/BU-D230/2B	TRAFDLITE	BLACK LETTERS ON WHITE BACKGROUND	50X15mm	4mm
U22.5001	U22.5001 IS-1	ALUMINUM PAPER FOIL	BLACK LETTERS	50X10mm	3mm
U22.5002	U22.5002 IS-2	ALUMINUM PAPER FOIL	BLACK LETTERS	50X10mm	3mm
U22.5003	U22.5003 IS-3	ALUMINUM PAPER FOIL	BLACK LETTERS	50X10mm	3mm
U22.5004	U22.5004 IS-4	ALUMINUM PAPER FOIL	BLACK LETTERS	50X10mm	3mm
U26.101	U26.101 748F-2/D120 /748F-2/D230	ALUMINUM PAPER FOIL	BLACK LETTERS	50X10mm	3mm
U39.5001	U39.5001 DC SUPPLY MCB FOR D120	TRAFOLITE	BLACK LETTERS ON WHITE BACKGROUND	50X15mm	4mm
U39.5002	U39.5002 DC SUPPLY MCB FOR D230	TRAFOLITE	BLACK LETTERS ON WHITE BACKGROUND	50X15mm	4mm
U39.5003	U39.5003 C01-127V,C02-220V	TRAFOLITE	BLACK LETTERS ON WHITE BACKGROUND	50X15mm	4mm
U39.5004	U39.5004 TJ	TRAFDLITE	BLACK LETTERS ON WHITE BACKGROUND	50X15mm	4mm

AS-BUILT BY _____ DATE _____			CONTRACT NO. 11131113/00		JOB ORDER NO. S-13656		LIST OF APPARATUS		<div> <div>الشركة الوطنية لنقل الكهرباء</div> <div>  <div>نقل الكهرباء</div> <div>National Grid sa</div> </div> </div>				
01	13 49	FACTORY ASBUILT	DRAWN BY RIZ		CHECKED BY KVR		132KV BUSBAR PROTN.MAIN-2 BU PANEL +BBP2-4		INDEX	PLANT NO.	DRAWING NUMBER	SHEET NO.	REV. NO.
00	13 05	FOR APPROVAL	DATE STARTED 31.01.2013		DATE COMPLETED		S/S 8709 - 132/13.8KV IN AL-KHARJ CITY		-	C421	CD-323006	L04 L05	01
REV. NO.	DATE	DESCRIPTION	PRG. DEPT. CTPD		ENG. DEPT. AUT-PSAC		RIYADH SAUDI ARABIA						

THIS DRAWING AND THE INFORMATION CONTAINED HEREIN ARE THE SOLE PROPERTY OF National Grid SA NO REPRODUCTION IN FULL OR IN PART SHALL BE OBTAINED FROM THIS DOCUMENT WITHOUT THE WRITTEN CONSENT OF ITS OWNER.

	1	2	3	4	5	6	7	8	9	10
A										
B										
C										
D										
E										
F										
G										

AS-BUILT BY _____ DATE _____		CONTRACT NO. 11131113/00		JOB ORDER NO. S-13656		LIST OF APPARATUS		الشركة الوطنية لنقل الكهرباء National Grid sa	
01	13 49	FACTORY ASBUILT		DRAWN BY RIZ CHECKED BY KVR		132KV BUSBAR PROTN.MAIN-2 BU PANEL +BBP2-4		INDEX	PLANT NO.
00	13 05	FOR APPROVAL		DATE STARTED 31.01.2013 DATE COMPLETED _____		S/S 8709 - 132/13.8KV IN AL-KHARJ CITY		DRAWING NUMBER	SHEET NO.
REV. NO.	DATE	DESCRIPTION		OPRG. DEPT. CTPD ENG. DEPT. AUT-PSAC		RIYADH SAUDI ARABIA		CD-323006	L05 NIL
								REV. NO.	01

NG/D2-D (2012/01)
DMS VECTOR NGD200

THIS DRAWING AND THE INFORMATION CONTAINED HEREIN ARE THE SOLE PROPERTY OF National Grid sa NO REPRODUCTION IN FULL OR IN PART SHALL BE OBTAINED FROM THIS DOCUMENT WITHOUT THE WRITTEN CONSENT OF ITS OWNER.



POWER SYSTEMS NETWORK MANAGEMENT
PROTECTION AND SUBSTATION AUTOMATION SYSTEMS
WBS NO: S-13656

ABB AUTOMATION COMPANY LTD.
414, AL-KHARJ ROAD
SECOND INDUSTRIAL CITY
RIYADH-11383 K.S.A

CONTRACTOR : ABB Contracting Company
CLIENT : National Gridsa
PROJECT : CONSTRUCTION OF NEW 132/13.8kV SS 8709 IN AL-KHARJ CITY
SUBSTATION : S/S 8709
CONTRACT NO. : 11131113/00
TITLE : SCHEMATICS DRAWINGS - +BBP2-4
[132KV BUSBAR PROTECTION MAIN-2 BAY UNIT PANEL]

AS-BUILT BY _____ DATE _____ CONTRACT NO. 11131113/00 JOB ORDER NO. S-13656

01	13 49	FACTORY ASBUILT	DRAWN BY RIZ	CHECKED BY KVR
00	13 05	FOR APPROVAL	DATE STARTED 31.01.2013	DATE COMPLETED _____
REV. NO.	DATE	DESCRIPTION	OPRG. DEPT. CTPD	ENG. DEPT. AUT-PSAC

COVER SHEET

132KV BUSBAR PROTN.MAIN-2 BU PANEL +BBP2-4
S/S 8709 - 132/13.8KV IN AL-KHARJ CITY
RIYADH SAUDI ARABIA

الشركة الوطنية لنقل الكهرباء



نقل الكهرباء
National Grid sa

INDEX	PLANT NO.	DRAWING NUMBER	SHEET NO.	REV. NO.
-	C421	CD-323007	SHT CONT. 000/001	01

NG/D2-D (2012/01)

DMS


VECTOR

NGD200

	1	2	3	4	5	6	7	8	9	10																																																																																																																		
A																																																																																																																												
B																																																																																																																												
C																																																																																																																												
D																																																																																																																												
E																																																																																																																												
F																																																																																																																												
	<table><tr><th>SYMBOL</th><th>DESCRIPTION</th><th>SYMBOL</th><th>DESCRIPTION</th><th>SYMBOL</th><th>DESCRIPTION</th></tr><tr><td></td><td>FRAME CONNECTION</td><td></td><td>MAIN CONTACT OF A CIRCUIT BREAKER</td><td></td><td>RELAY WITH TWO MAKE CONTACTS, ONE OF THEM DELAYED WHEN OPERATING</td></tr><tr><td></td><td>EARTH CONNECTION</td><td></td><td>PASSING MAKE CONTACT CLOSING MOMENTARILY DURING OPERATION AND RELEASE</td><td></td><td>RELAY WITH TWO ACTUATORS AND A TWO STABLE POSITIONS</td></tr><tr><td></td><td>RESISTOR</td><td></td><td>BREAK CONTACT DELAYED WHEN OPERATING</td><td></td><td></td></tr><tr><td></td><td>VARIABLE RESISTOR</td><td></td><td>MAKE CONTACT DELAYED WHEN RELEASING</td><td></td><td>SIGNALLING LAMP</td></tr><tr><td></td><td>RESISTOR WITH PRESET ADJUSTMENT</td><td></td><td>TWO MECHANICAL LINKS CROSSING WITHOUT CONNECTION</td><td></td><td>MECHANICAL INDICATOR WITH AUTOMATIC RESET</td></tr><tr><td></td><td>CAPACITOR</td><td></td><td>JUNCTION OF MECHANICAL LINKS</td><td></td><td>MECHANICAL INDICATOR WITH NON-AUTOMATIC RESET</td></tr><tr><td></td><td>SEMICONDUCTOR DIODE USED AS A CAPACITIVE DEVICE</td><td></td><td>AUTOMATIC RESET</td><td></td><td>ELECTRICALLY CONTROLLED MECHANICAL INDICATOR WITH AUTOMATIC RESET</td></tr><tr><td></td><td>OPEN CONTACT, MAKE CONTACT</td><td></td><td>NON-AUTOMATIC RESET</td><td></td><td>ELECTRICALLY CONTROLLED MECHANICAL INDICATOR WITH NON-AUTOMATIC RESET</td></tr><tr><td></td><td>CLOSED CONTACT, BREAK CONTACT</td><td></td><td>SWITCHING DEVICE WITH MANUAL OPERATION AND WITH AUTOMATIC RESET</td><td></td><td>RELAY WITH MECHANICAL INDICATOR</td></tr><tr><td></td><td>CHANGE-OVER CONTACT, BREAK BEFORE MAKE</td><td></td><td>SWITCHING DEVICE WITH MANUAL OPERATION AND WITH NON-AUTOMATIC RESET</td><td></td><td>ELECTRO-MECHANICAL POSITION INDICATOR WITH ONE DE-ENERGIZED AND ONE OPERATED POSITION</td></tr><tr><td></td><td>MAKE CONTACT WHICH IS EARLY WHEN OPERATING AND LATE WHEN RELEASING</td><td></td><td>CHANGE-OVER SWITCHING DEVICE WITH MANUAL CONTROL</td><td></td><td>ELECTRO-MECHANICAL POSITION INDICATOR WITH ONE DE-ENERGIZED AND TWO OPERATED POSITIONS</td></tr><tr><td></td><td>BREAK CONTACT WHICH IS LATE WHEN OPERATING AND EARLY WHEN RELEASING</td><td></td><td>RELAY WITH MAKE CONTACT</td><td></td><td>BELL, BUZZER</td></tr><tr><td></td><td>SWITCHING DEVICE WITH MANUAL CONTROL</td><td></td><td>RELAY WITH CHANGE-OVER CONTACT</td><td></td><td>SIREN , HORN</td></tr><tr><td></td><td>MAKE CONTACT DELAYED WHEN OPERATING</td><td></td><td>RELAY WITH MAKE CONTACT, DELAYED WHEN OPERATING</td><td></td><td></td></tr><tr><td></td><td>BREAK CONTACT DELAYED WHEN RELEASING</td><td></td><td>RELAY WITH MAKE CONTACT, DELAYED WHEN RELEASING</td><td></td><td></td></tr><tr><td></td><td>MAKE CONTACT DELAYED WHEN OPERATING AND RELEASING</td><td></td><td>RELAY WITH MAKE CONTACT, DELAYED WHEN OPERATING AND RELEASING</td><td></td><td></td></tr><tr><td></td><td>MAIN CONTACT OF A SWITCH DISCONNECTOR</td><td></td><td></td><td></td><td></td></tr><tr><td></td><td>MAIN CONTACT OF A DISCONNECTOR</td><td></td><td></td><td></td><td></td></tr></table>										SYMBOL	DESCRIPTION	SYMBOL	DESCRIPTION	SYMBOL	DESCRIPTION		FRAME CONNECTION		MAIN CONTACT OF A CIRCUIT BREAKER		RELAY WITH TWO MAKE CONTACTS, ONE OF THEM DELAYED WHEN OPERATING		EARTH CONNECTION		PASSING MAKE CONTACT CLOSING MOMENTARILY DURING OPERATION AND RELEASE		RELAY WITH TWO ACTUATORS AND A TWO STABLE POSITIONS		RESISTOR		BREAK CONTACT DELAYED WHEN OPERATING				VARIABLE RESISTOR		MAKE CONTACT DELAYED WHEN RELEASING		SIGNALLING LAMP		RESISTOR WITH PRESET ADJUSTMENT		TWO MECHANICAL LINKS CROSSING WITHOUT CONNECTION		MECHANICAL INDICATOR WITH AUTOMATIC RESET		CAPACITOR		JUNCTION OF MECHANICAL LINKS		MECHANICAL INDICATOR WITH NON-AUTOMATIC RESET		SEMICONDUCTOR DIODE USED AS A CAPACITIVE DEVICE		AUTOMATIC RESET		ELECTRICALLY CONTROLLED MECHANICAL INDICATOR WITH AUTOMATIC RESET		OPEN CONTACT, MAKE CONTACT		NON-AUTOMATIC RESET		ELECTRICALLY CONTROLLED MECHANICAL INDICATOR WITH NON-AUTOMATIC RESET		CLOSED CONTACT, BREAK CONTACT		SWITCHING DEVICE WITH MANUAL OPERATION AND WITH AUTOMATIC RESET		RELAY WITH MECHANICAL INDICATOR		CHANGE-OVER CONTACT, BREAK BEFORE MAKE		SWITCHING DEVICE WITH MANUAL OPERATION AND WITH NON-AUTOMATIC RESET		ELECTRO-MECHANICAL POSITION INDICATOR WITH ONE DE-ENERGIZED AND ONE OPERATED POSITION		MAKE CONTACT WHICH IS EARLY WHEN OPERATING AND LATE WHEN RELEASING		CHANGE-OVER SWITCHING DEVICE WITH MANUAL CONTROL		ELECTRO-MECHANICAL POSITION INDICATOR WITH ONE DE-ENERGIZED AND TWO OPERATED POSITIONS		BREAK CONTACT WHICH IS LATE WHEN OPERATING AND EARLY WHEN RELEASING		RELAY WITH MAKE CONTACT		BELL, BUZZER		SWITCHING DEVICE WITH MANUAL CONTROL		RELAY WITH CHANGE-OVER CONTACT		SIREN , HORN		MAKE CONTACT DELAYED WHEN OPERATING		RELAY WITH MAKE CONTACT, DELAYED WHEN OPERATING				BREAK CONTACT DELAYED WHEN RELEASING		RELAY WITH MAKE CONTACT, DELAYED WHEN RELEASING				MAKE CONTACT DELAYED WHEN OPERATING AND RELEASING		RELAY WITH MAKE CONTACT, DELAYED WHEN OPERATING AND RELEASING				MAIN CONTACT OF A SWITCH DISCONNECTOR						MAIN CONTACT OF A DISCONNECTOR				
SYMBOL	DESCRIPTION	SYMBOL	DESCRIPTION	SYMBOL	DESCRIPTION																																																																																																																							
	FRAME CONNECTION		MAIN CONTACT OF A CIRCUIT BREAKER		RELAY WITH TWO MAKE CONTACTS, ONE OF THEM DELAYED WHEN OPERATING																																																																																																																							
	EARTH CONNECTION		PASSING MAKE CONTACT CLOSING MOMENTARILY DURING OPERATION AND RELEASE		RELAY WITH TWO ACTUATORS AND A TWO STABLE POSITIONS																																																																																																																							
	RESISTOR		BREAK CONTACT DELAYED WHEN OPERATING																																																																																																																									
	VARIABLE RESISTOR		MAKE CONTACT DELAYED WHEN RELEASING		SIGNALLING LAMP																																																																																																																							
	RESISTOR WITH PRESET ADJUSTMENT		TWO MECHANICAL LINKS CROSSING WITHOUT CONNECTION		MECHANICAL INDICATOR WITH AUTOMATIC RESET																																																																																																																							
	CAPACITOR		JUNCTION OF MECHANICAL LINKS		MECHANICAL INDICATOR WITH NON-AUTOMATIC RESET																																																																																																																							
	SEMICONDUCTOR DIODE USED AS A CAPACITIVE DEVICE		AUTOMATIC RESET		ELECTRICALLY CONTROLLED MECHANICAL INDICATOR WITH AUTOMATIC RESET																																																																																																																							
	OPEN CONTACT, MAKE CONTACT		NON-AUTOMATIC RESET		ELECTRICALLY CONTROLLED MECHANICAL INDICATOR WITH NON-AUTOMATIC RESET																																																																																																																							
	CLOSED CONTACT, BREAK CONTACT		SWITCHING DEVICE WITH MANUAL OPERATION AND WITH AUTOMATIC RESET		RELAY WITH MECHANICAL INDICATOR																																																																																																																							
	CHANGE-OVER CONTACT, BREAK BEFORE MAKE		SWITCHING DEVICE WITH MANUAL OPERATION AND WITH NON-AUTOMATIC RESET		ELECTRO-MECHANICAL POSITION INDICATOR WITH ONE DE-ENERGIZED AND ONE OPERATED POSITION																																																																																																																							
	MAKE CONTACT WHICH IS EARLY WHEN OPERATING AND LATE WHEN RELEASING		CHANGE-OVER SWITCHING DEVICE WITH MANUAL CONTROL		ELECTRO-MECHANICAL POSITION INDICATOR WITH ONE DE-ENERGIZED AND TWO OPERATED POSITIONS																																																																																																																							
	BREAK CONTACT WHICH IS LATE WHEN OPERATING AND EARLY WHEN RELEASING		RELAY WITH MAKE CONTACT		BELL, BUZZER																																																																																																																							
	SWITCHING DEVICE WITH MANUAL CONTROL		RELAY WITH CHANGE-OVER CONTACT		SIREN , HORN																																																																																																																							
	MAKE CONTACT DELAYED WHEN OPERATING		RELAY WITH MAKE CONTACT, DELAYED WHEN OPERATING																																																																																																																									
	BREAK CONTACT DELAYED WHEN RELEASING		RELAY WITH MAKE CONTACT, DELAYED WHEN RELEASING																																																																																																																									
	MAKE CONTACT DELAYED WHEN OPERATING AND RELEASING		RELAY WITH MAKE CONTACT, DELAYED WHEN OPERATING AND RELEASING																																																																																																																									
	MAIN CONTACT OF A SWITCH DISCONNECTOR																																																																																																																											
	MAIN CONTACT OF A DISCONNECTOR																																																																																																																											

AS-BUILT BY	DATE	CONTRACT NO.	11131113/00	JOB ORDER NO.	S-13656	GRAPHICAL SYMBOLS FOR DIAGRAMS		الشركة الوطنية لنقل الكهرباء		نقل الكهرباء	
01	13 49	FACTORY ASBUILT	DRAWN BY	RIZ	CHECKED BY	KVR	32KV BUSBAR PROTN.MAIN-2 BU PANEL +BBP2-4	National Grid sa			
00	13 05	FOR APPROVAL	DATE STARTED	31.01.2013	DATE COMPLETED		S/S 8709 - 132/13.8KV IN AL-KHARJ CITY	INDEX		PLANT NO.	DRAWING NUMBER
REV. NO.	DATE	DESCRIPTION	OPRG. DEPT.	CTPD	ENG. DEPT.	AUT-PSAC	RIYADH	-		C421	CD-323007
							SAUDI ARABIA	SHEET NO.		REV. NO.	
								SHT		CDT	01
								011		012	
								NG/D2-0 (2012/01)			
								DMS		VECTOR	NGD200

	1	2	3	4	5	6	7	8	9	10																																																																																																						
A																																																																																																																
B																																																																																																																
C																																																																																																																
D																																																																																																																
E																																																																																																																
F																																																																																																																
	<table><tr><th>SYMBOL</th><th>DESCRIPTION</th><th>SYMBOL</th><th>DESCRIPTION</th><th>SYMBOL</th><th>DESCRIPTION</th></tr><tr><td></td><td>FUSE / LINK</td><td></td><td>WATTMETER</td><td></td><td>ELEMENT WITH NEGATED INHIBITING INPUT</td></tr><tr><td></td><td>FUSE WITH THE SUPPLY SIDE INDICATED</td><td></td><td>VARMETER</td><td></td><td>ELEMENT WITH INPUT WHICH DOES NOT CARRY ANY LOGIC INFORMATION</td></tr><tr><td></td><td>SINGLE-PHASE TRANSFORMER WITH TWO SEPARATE WINDINGS (TWO ALTERNATIVE FORMS)</td><td></td><td>POWER FACTOR METER</td><td></td><td>ELEMENT WITH POSTPONED OUTPUT</td></tr><tr><td></td><td>SINGLE-PHASE TRANSFORMER WITH TWO SEPARATE WINDINGS (TWO ALTERNATIVE FORMS)</td><td></td><td>POSITION INDICATOR</td><td></td><td>AND-ELEMENT WITH TWO INPUTS</td></tr><tr><td></td><td>SINGLE-PHASE TRANSFORMER WITH FERRO MAGNETIC CORE</td><td></td><td>SYNCHROSCOPE</td><td></td><td>OR-ELEMENT WITH TWO INPUTS</td></tr><tr><td></td><td>SINGLE-PHASE VOLTAGE TRANSFORMER (MULTI-LINE AND SINGLE-LINE REPRESENTATION)</td><td></td><td>RECORDING VOLTMETER</td><td></td><td>LOGIC THRESHOLD ELEMENT WITH FOUR INPUTS AND THRESHOLD VALUE 2</td></tr><tr><td></td><td>SINGLE-PHASE VOLTAGE TRANSFORMER WITH TWO SECONDARY WINDINGS (MULTI-LINE AND SINGLE-LINE REPRESENTATION)</td><td></td><td>RECORDING WATTMETER</td><td></td><td>ELEMENT WITH THREE INPUTS FOR "2 AND ONLY 2"</td></tr><tr><td></td><td>CURRENT TRANSFORMER (MULTI-LINE AND SINGLE-LINE REPRESENTATION)</td><td></td><td>HOUR METER</td><td></td><td>EXCLUSIVE OR-ELEMENT WITH THREE INPUTS</td></tr><tr><td></td><td>CURRENT TRANSFORMER WITH TWO CORES (MULTI-LINE AND SINGLE-LINE REPRESENTATION)</td><td></td><td>WATT-HOUR METER</td><td></td><td>LOGIC IDENTITY ELEMENT WITH THREE INPUTS</td></tr><tr><td></td><td>CURRENT TRANSFORMER WITH TWO SECONDARY WINDINGS ON ONE CORE (MULTI-LINE AND SINGLE-LINE REPRESENTATION)</td><td></td><td>WATT-HOUR METER FOR ENERGY FROM A BUSBAR SYSTEM</td><td></td><td>MAJORITY ELEMENT WITH THREE INPUTS</td></tr><tr><td></td><td>FILTER</td><td></td><td>ELEMENT WITH STATIC INPUT</td><td></td><td>NEGATOR</td></tr><tr><td></td><td>HIGH-PASS FILTER</td><td></td><td>ELEMENT WITH STATIC NEGATED INPUT</td><td></td><td>NAND ELEMENT WITH TWO INPUTS</td></tr><tr><td></td><td>BAND-PASS FILTER</td><td></td><td>ELEMENT WITH STATIC NEGATED OUTPUT</td><td></td><td>NOR ELEMENT WITH TWO INPUTS</td></tr><tr><td></td><td>VOLTMETER</td><td></td><td>ELEMENT WITH DYNAMIC INPUT</td><td></td><td>BISTABLE ELEMENT</td></tr><tr><td></td><td>AMMETER</td><td></td><td>ELEMENT WITH DYNAMIC NEGATED INPUT</td><td></td><td></td></tr><tr><td></td><td></td><td></td><td>ELEMENT WITH INHIBITING INPUT</td><td></td><td></td></tr></table>										SYMBOL	DESCRIPTION	SYMBOL	DESCRIPTION	SYMBOL	DESCRIPTION		FUSE / LINK		WATTMETER		ELEMENT WITH NEGATED INHIBITING INPUT		FUSE WITH THE SUPPLY SIDE INDICATED		VARMETER		ELEMENT WITH INPUT WHICH DOES NOT CARRY ANY LOGIC INFORMATION		SINGLE-PHASE TRANSFORMER WITH TWO SEPARATE WINDINGS (TWO ALTERNATIVE FORMS)		POWER FACTOR METER		ELEMENT WITH POSTPONED OUTPUT		SINGLE-PHASE TRANSFORMER WITH TWO SEPARATE WINDINGS (TWO ALTERNATIVE FORMS)		POSITION INDICATOR		AND-ELEMENT WITH TWO INPUTS		SINGLE-PHASE TRANSFORMER WITH FERRO MAGNETIC CORE		SYNCHROSCOPE		OR-ELEMENT WITH TWO INPUTS		SINGLE-PHASE VOLTAGE TRANSFORMER (MULTI-LINE AND SINGLE-LINE REPRESENTATION)		RECORDING VOLTMETER		LOGIC THRESHOLD ELEMENT WITH FOUR INPUTS AND THRESHOLD VALUE 2		SINGLE-PHASE VOLTAGE TRANSFORMER WITH TWO SECONDARY WINDINGS (MULTI-LINE AND SINGLE-LINE REPRESENTATION)		RECORDING WATTMETER		ELEMENT WITH THREE INPUTS FOR "2 AND ONLY 2"		CURRENT TRANSFORMER (MULTI-LINE AND SINGLE-LINE REPRESENTATION)		HOUR METER		EXCLUSIVE OR-ELEMENT WITH THREE INPUTS		CURRENT TRANSFORMER WITH TWO CORES (MULTI-LINE AND SINGLE-LINE REPRESENTATION)		WATT-HOUR METER		LOGIC IDENTITY ELEMENT WITH THREE INPUTS		CURRENT TRANSFORMER WITH TWO SECONDARY WINDINGS ON ONE CORE (MULTI-LINE AND SINGLE-LINE REPRESENTATION)		WATT-HOUR METER FOR ENERGY FROM A BUSBAR SYSTEM		MAJORITY ELEMENT WITH THREE INPUTS		FILTER		ELEMENT WITH STATIC INPUT		NEGATOR		HIGH-PASS FILTER		ELEMENT WITH STATIC NEGATED INPUT		NAND ELEMENT WITH TWO INPUTS		BAND-PASS FILTER		ELEMENT WITH STATIC NEGATED OUTPUT		NOR ELEMENT WITH TWO INPUTS		VOLTMETER		ELEMENT WITH DYNAMIC INPUT		BISTABLE ELEMENT		AMMETER		ELEMENT WITH DYNAMIC NEGATED INPUT						ELEMENT WITH INHIBITING INPUT		
SYMBOL	DESCRIPTION	SYMBOL	DESCRIPTION	SYMBOL	DESCRIPTION																																																																																																											
	FUSE / LINK		WATTMETER		ELEMENT WITH NEGATED INHIBITING INPUT																																																																																																											
	FUSE WITH THE SUPPLY SIDE INDICATED		VARMETER		ELEMENT WITH INPUT WHICH DOES NOT CARRY ANY LOGIC INFORMATION																																																																																																											
	SINGLE-PHASE TRANSFORMER WITH TWO SEPARATE WINDINGS (TWO ALTERNATIVE FORMS)		POWER FACTOR METER		ELEMENT WITH POSTPONED OUTPUT																																																																																																											
	SINGLE-PHASE TRANSFORMER WITH TWO SEPARATE WINDINGS (TWO ALTERNATIVE FORMS)		POSITION INDICATOR		AND-ELEMENT WITH TWO INPUTS																																																																																																											
	SINGLE-PHASE TRANSFORMER WITH FERRO MAGNETIC CORE		SYNCHROSCOPE		OR-ELEMENT WITH TWO INPUTS																																																																																																											
	SINGLE-PHASE VOLTAGE TRANSFORMER (MULTI-LINE AND SINGLE-LINE REPRESENTATION)		RECORDING VOLTMETER		LOGIC THRESHOLD ELEMENT WITH FOUR INPUTS AND THRESHOLD VALUE 2																																																																																																											
	SINGLE-PHASE VOLTAGE TRANSFORMER WITH TWO SECONDARY WINDINGS (MULTI-LINE AND SINGLE-LINE REPRESENTATION)		RECORDING WATTMETER		ELEMENT WITH THREE INPUTS FOR "2 AND ONLY 2"																																																																																																											
	CURRENT TRANSFORMER (MULTI-LINE AND SINGLE-LINE REPRESENTATION)		HOUR METER		EXCLUSIVE OR-ELEMENT WITH THREE INPUTS																																																																																																											
	CURRENT TRANSFORMER WITH TWO CORES (MULTI-LINE AND SINGLE-LINE REPRESENTATION)		WATT-HOUR METER		LOGIC IDENTITY ELEMENT WITH THREE INPUTS																																																																																																											
	CURRENT TRANSFORMER WITH TWO SECONDARY WINDINGS ON ONE CORE (MULTI-LINE AND SINGLE-LINE REPRESENTATION)		WATT-HOUR METER FOR ENERGY FROM A BUSBAR SYSTEM		MAJORITY ELEMENT WITH THREE INPUTS																																																																																																											
	FILTER		ELEMENT WITH STATIC INPUT		NEGATOR																																																																																																											
	HIGH-PASS FILTER		ELEMENT WITH STATIC NEGATED INPUT		NAND ELEMENT WITH TWO INPUTS																																																																																																											
	BAND-PASS FILTER		ELEMENT WITH STATIC NEGATED OUTPUT		NOR ELEMENT WITH TWO INPUTS																																																																																																											
	VOLTMETER		ELEMENT WITH DYNAMIC INPUT		BISTABLE ELEMENT																																																																																																											
	AMMETER		ELEMENT WITH DYNAMIC NEGATED INPUT																																																																																																													
			ELEMENT WITH INHIBITING INPUT																																																																																																													

 G	AS-BUILT BY _____		DATE _____	CONTRACT NO. 1113113/00		JOB ORDER NO. S-13656		GRAPHICAL SYMBOLS FOR DIAGRAMS				الشركة الوطنية لنقل الكهرباء				نقل الكهرباء	
	DRAWN BY _____ RIZ _____		CHECKED BY _____ KVR _____		132KV BUSBAR PROTN.MAIN-2 BU PANEL +BBP2-4				National Grid SA								
	DATE STARTED 31.01.2013		DATE COMPLETED _____		S/S 8709 - 132/13.8KV IN AL-KHARJ CITY				INDEX	PLANT NO.	DRAWING NUMBER		SHEET NO.		REV. NO.		
	PRG. DEPT. _____ CTPD _____		ENG. DEPT. _____ AUT-PSAC _____		RIYADH SAUDI ARABIA				-	C421	CD-323007		SHT CONT.		01		
	REV. NO.		DATE		DESCRIPTION								012 013				
														NG/D2-D (2012/01			
														NGD200			

	1	2	3	4	5	6	7	8	9	10
A										
B										
C										
D										
E										
F										

LEGENDS

±R1	DC SUPPLY - MAIN PROTECTION
±R2	DC SUPPLY - SECONDARY PROTECTION
±R3	DC SUPPLY - BACK UP PROTECTION
±IT	DC SUPPLY - INTER TRIP
FL	DC SUPPLY - FLASHING CIRCUIT
BB RS±	DC SUPPLY - BUS BAR - PROTECTION RESET
BB CBF±/CBF±	DC SUPPLY - CBF PROTECTION
R	RESET BUS - ALARM SYSTEM
CR	CONTROL ROOM
ECC	ENERGY CONTROL CENTRE
LOCAL	THE LOCATION OF CONTROLLED DEVICE
REMOTE	ANY OTHER LOCATION NOT LOCAL
ON	CB NORMALLY OPEN AUXILIARY CONTACT
OFF	CB NORMALLY CLOSED AUXILIARY CONTACT
A	COMMON
T	TEST POSITION
S	SERVICE POSITION
CS	CLOSE IN SERVICE POSITION
CT	CLOSE IN TEST POSITION
LS	LOCAL SERVICE
LT	LOCAL TEST
LC	LOCAL CLOSE
LO	LOCAL OPEN
RO	REMOTE OPEN
OP	OPERATE
RE	RESET

NOTES

LABELS

WHITE LABEL WITH BLACK LETTERING WILL BE PROVIDED FOR ALL MOUNTED APPARATUS EQUIPMENT IDENTIFICATION AND FUNCTION REFERENCE LABEL WILL BE PROVIDED FOR FRONT MOUNTED EQUIPMENTS OF THE PANEL AND EQUIPMENT IDENTIFICATION LABEL WILL BE PROVIDED FOR INTERNALLY MOUNTED EQUIPMENTS

WIRING

PVC INSULATED 600V GRADE
 2.5 SQ.mm. YELLOW COLOURED FOR CT CIRCUITS
 2.5 SQ.mm. RE COLOURED FOR VT CIRCUITS
 1.5 SQ.mm. GREY COLOURED FOR DC SUPPLY, SCADA AND CONTROL CIRCUITS
 2.5 SQ.mm. BLACK COLOURED FOR AVC AND AC CIRCUITS
 2.5 SQ.mm. YELLOW/GREEN COLOURED FOR EARTHING CONNECTIONS
 FOLLOWING MARKERS SHALL BE PROVIDED ON FOLLOWING WIRES:
 + SIGN FOR DC + WIRE
 - SIGN FOR DC - WIRE

LUGS

A. CT CIRCUITS- RING TYPE
 B. OTHER CIRCUITS - SPADE TYPE

FERULLING

YELLOW TUBE 3.2 mm FOR 1.5SQ mm WIRES AND 4.2 FOR 2.5 SQ mm WIRES
 (AS PER 31 - TMSS-1, RE.0)

AS-BUILT BY _____ DATE _____

CONTRACT NO. 1113113/00

JOB ORDER NO. S-13656

01

13 49

FACTORY ASBUILT

00

13 05

FOR APPROVAL

REV. NO.

DATE

DESCRIPTION

DRAWN BY RIZ

CHECKED BY KVR

DATE STARTED 31.01.2013

DATE COMPLETED _____

OPRG. DEPT. CTPD


ENG. DEPT. AUT-PSAC

COMMON LEGEND


132KV BUSBAR PROTN.MAIN-2 BU PANEL +BBP2-4

S/S 8709 - 132/13.8KV IN AL-KHARJ CITY

RIYADH SAUDI ARABIA



الشركة الوطنية لنقل الكهرباء



National Grid sa

INDEX

PLANT NO.

DRAWING NUMBER

SHEET NO.

REV. NO.

-

C421

CD-323007

SHT

CONT.

01

NG/D2-D (2012/01)

DMS

VECTOR

NGD200

1 2 3 4 5 6 7 8 9 10

A

B

C


D

E

F


G

FOR 132kV RELAY & CONTROL, PROTN. PANELS

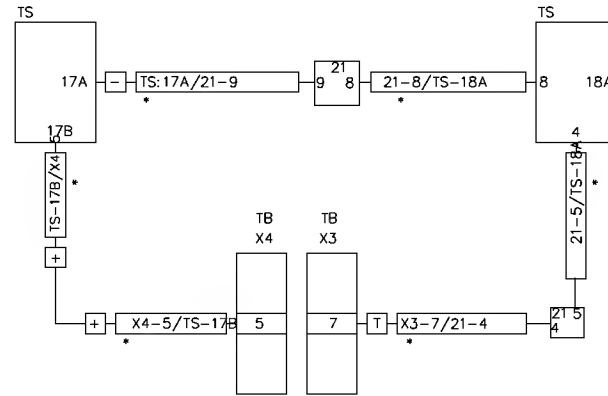

AS PER IEC-391 FIG 14a (W/O SUPPLEMENTARY/IDENTIFICATION MARK)

FOR 132kV PANELS INTERPANEL WIRING

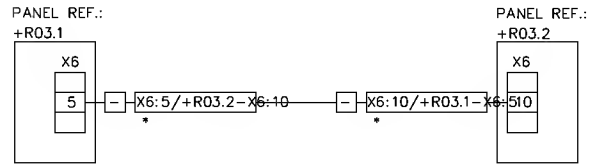

AS PER IEC-391 FIG 14d (W/O SUPPLEMENTARY/IDENTIFICATION MARK)

WIRES -
PVC insulated, stranded,
cooled annealed copper
conductor graded for 1000V

LUGS -
Pre-Insulated

a. CT Circuits - 2.5 Sqmm PVC Yellow colour

b. VT Circuits - 1.5 Sqmm PVC Red colour

c. DC, & CONTROL Circuits - 1.5 Sqmm
PVC Grey colour

d. Alarm Circuits - 1.0 Sqmm PVC Blue colour

e. AVC & AC Circuits - 2.5 Sqmm PVC Black colour

f. Earth Circuits - 2.5 Sqmm PVC Yellow/Green colour

a) CT Circuits - Ring type

b) Other Circuits - Spode type

NOTE:1 ADDITIONAL MARKING AS APPLICABLE

NOTE:2 FERRULE NUMBERING WILL BE BLACK
LETTERS ON YELLOW TUBE

3.2 mm for 1.5 sq mm wires and

4.2 mm for 2.5 sq mm wires

(As per 31-TMSS-1, REV 0)

NOTE:3 STARTING POINT OF THE
FERRULE LEFT TO RIGHT

AS-BUILT BY _____ DATE _____ CONTRACT NO. 1113113/00 JOB ORDER NO. S-13656

01	13 49	FACTORY ASBUILT
00	13 05	FOR APPROVAL
REV. NO.	DATE	DESCRIPTION

DRAWN BY RIZ CHECKED BY KVR
DATE STARTED 31.01.2013 DATE COMPLETED _____
OPRG. DEPT. CTPD ENG. DEPT. AUT-PSAC

FERRULE AND WIRING DETAILS

132KV BUSBAR PROTN.MAIN-2 BU PANEL +BBP2-4
S/S 8709 - 132/13.8KV IN AL-KHARJ CITY
RIYADH SAUDI ARABIA

الشركة الوطنية لنقل الكهرباء

نقل الكهرباء
National Grid sa

INDEX	PLANT NO.	DRAWING NUMBER	SHEET NO.	REV. NO.
-	C421	CD-323007	014	01

NG/02-0 (2012/01)

DMS

VECTOR

NG0200

NO REF. IN FULL OR IN PART SHALL BE OBTAINED FROM THIS DOCUMENT WITHOUT THE WRITTEN CONSENT OF ITS OWNER.

	1	2	3	4	5	6	7	8	9	10
A										
B										
C										
D										
E										
F										
G										


ABB

PROTECTION & SUBSTATION
AUTOMATION

MANUFACTURER	SCHEMATICS DWG.NO	PANEL DESCRIPTION	PANEL REFERENCE
		SS 8709 13.8KV RELAY PANELS	
	CD-322952	13.8KV Capacitor Bank-1 Protection Panel	+C8P-1
	CD-322954	13.8KV Capacitor Bank-2 Protection Panel	+C8P-2
	CD-322956	13.8KV Capacitor Bank-2 Protection Panel	+CBP-3
	CD-322958	13.8 KV ACCS PANEL	+ACCS
	CD-322962	13.8KV ACSE PANEL	+ACSE
	CD-322968	13.8KV Under Voltage Load Shedding Panel	+UVLS
	CD-322964	13.8KV Under Frequency Load Shedding Panel-1	+UFLS01
	CD-322966	13.8KV Under Frequency Load Shedding Panel-2	+UFLS02

AS-BUILT by _____ DATE _____			CONTRACT NO. 11131113/00		JOB ORDER NO. S-13656		DRAWING REFERENCES			الشركة الوطنية لنقل الكهرباء National Grid sa			
01 13 49 FACTORY ASBUILT			DRAWN BY RIZ CHECKED BY KVR		132KV BUSBAR PROTN.MAIN-2 BU PANEL +BBP2-4			INDEX		PLANT NO.	DRAWING NUMBER	SHEET NO.	REV. NO.
00 13 05 FOR APPROVAL			DATE STARTED 31.01.2013 DATE COMPLETED _____		S/S 8709 - 132/13.8KV IN AL-KHARJ CITY							SHT CONT.	
REV. NO.	DATE	DESCRIPTION	OPRG. DEPT. CTPD ENG. DEPT. AUT-PSAC		RIYADH SAUDI ARABIA			-		C421	CD-323007	016 051	01

NG/D2-D (2012/01)
DMS VECTOR NGD200

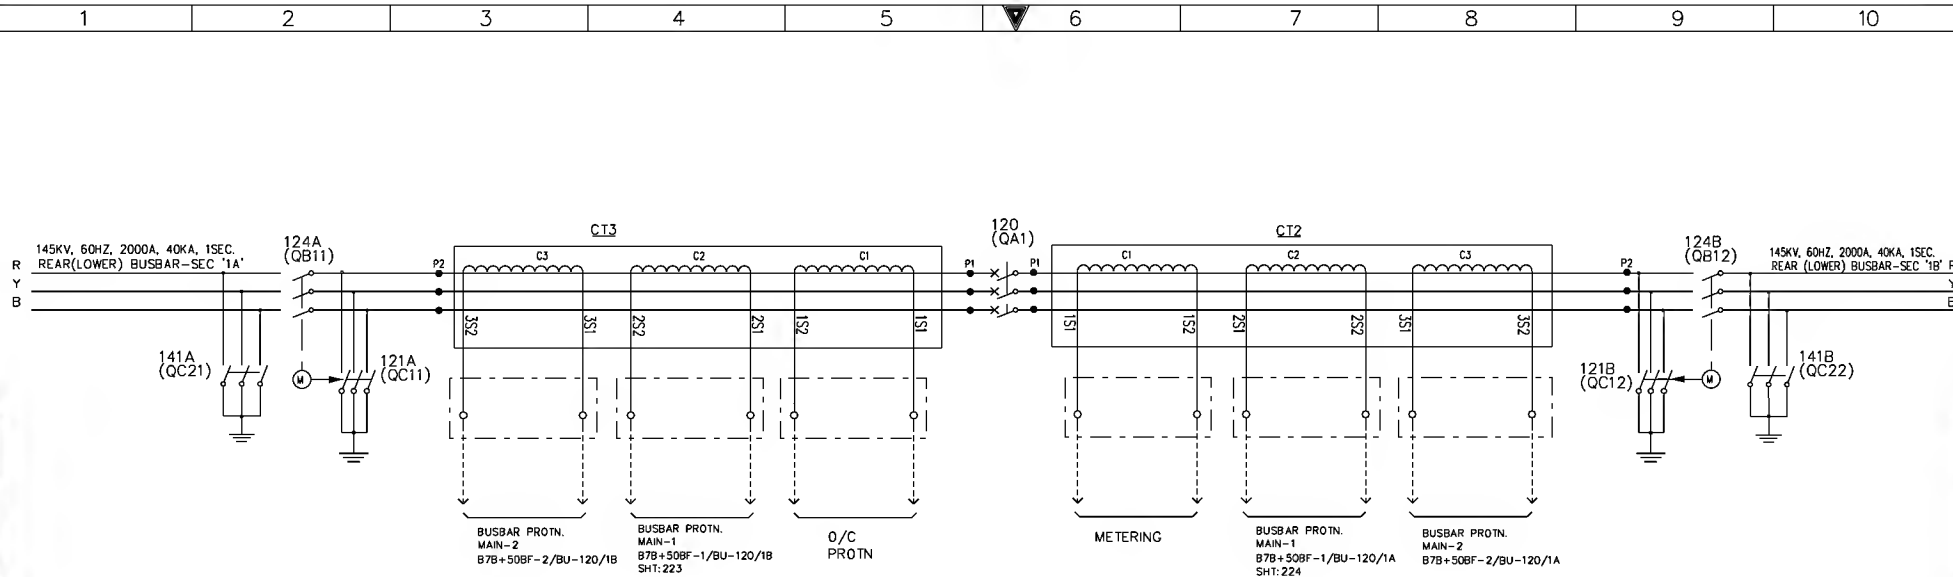

LOCATION OF GIS CT	CT	RATIO	CLASS	VK IN VOLT	Image IN mA @ VK	RCT IN OHMS	BURDEN IN VA	BURDEN IN VA
BUS 1A	CT3 CORE-1	2000/1A	0.2 ISF<10	--	--	--	30	CONTROL IED (BCU) + METERING
	CT3 CORE-2	2000/1A	X	>600 at 2000/1A TAP	< = 25	<5	--	87B+50BF-1/BU-120/1B MAIN-1
	CT3 CORE-3	2000/1A	X	>600 at 2000/1A TAP	< = 25	<5	--	87B+50BF-2/BU-120/1B MAIN-2
BUS 1B	CT2 CORE-1	2000/1A	X	>600 at 2000/1A TAP	< = 25	<5	--	50+62BF+50/51+50/51N
	CT2 CORE-2	2000/1A	X	>600 at 2000/1A TAP	< = 25	<5	--	87B+50BF-1/BU-120/1A MAIN-1
	CT2 CORE-3	2000/1A	X	>600 at 2000/1A TAP	< = 25	<5	--	87B+50BF-2/BU-120/1A MAIN-2

AS-BUILT BY _____ DATE _____ CONTRACT NO. 1113113/00 JOB ORDER NO. S-13656

01	13 49	FACTORY ASBUILT
00	13 05	FOR APPROVAL
REV. NO.	DATE	DESCRIPTION


DRAWN BY RIZ CHECKED BY KVR
 DATE STARTED 31.01.2013 DATE COMPLETED _____
 PRG. DEPT. CTPD ENG. DEPT. AUT-PSAC

PRIMARY SYSTEM BUS SECTION 120
 32KV BUSBAR PROTN.MAIN-2 BU PANEL +BBP2-4
 S/S 8709 - 132/13.8KV IN AL-KHARJ CITY
 RIYADH SAUDI ARABIA

الشركة الوطنية لنقل الكهرباء		نقل الكهرباء		National Grid sa	
INDEX	PLANT NO.	DRAWING NUMBER	SHEET NO.	SHT CONT.	REV. NO.
-	C421	CD-323007	051	052	01

NG/D2-D (2012/01)
 DMS VECTOR NGD200




THIS DRAWING AND THE INFORMATION CONTAINED HEREIN ARE THE SOLE PROPERTY OF National Grid SA. NO REPRODUCTION IN FULL OR IN PART SHALL BE OBTAINED FROM THIS DOCUMENT WITHOUT THE WRITTEN CONSENT OF ITS OWNER.

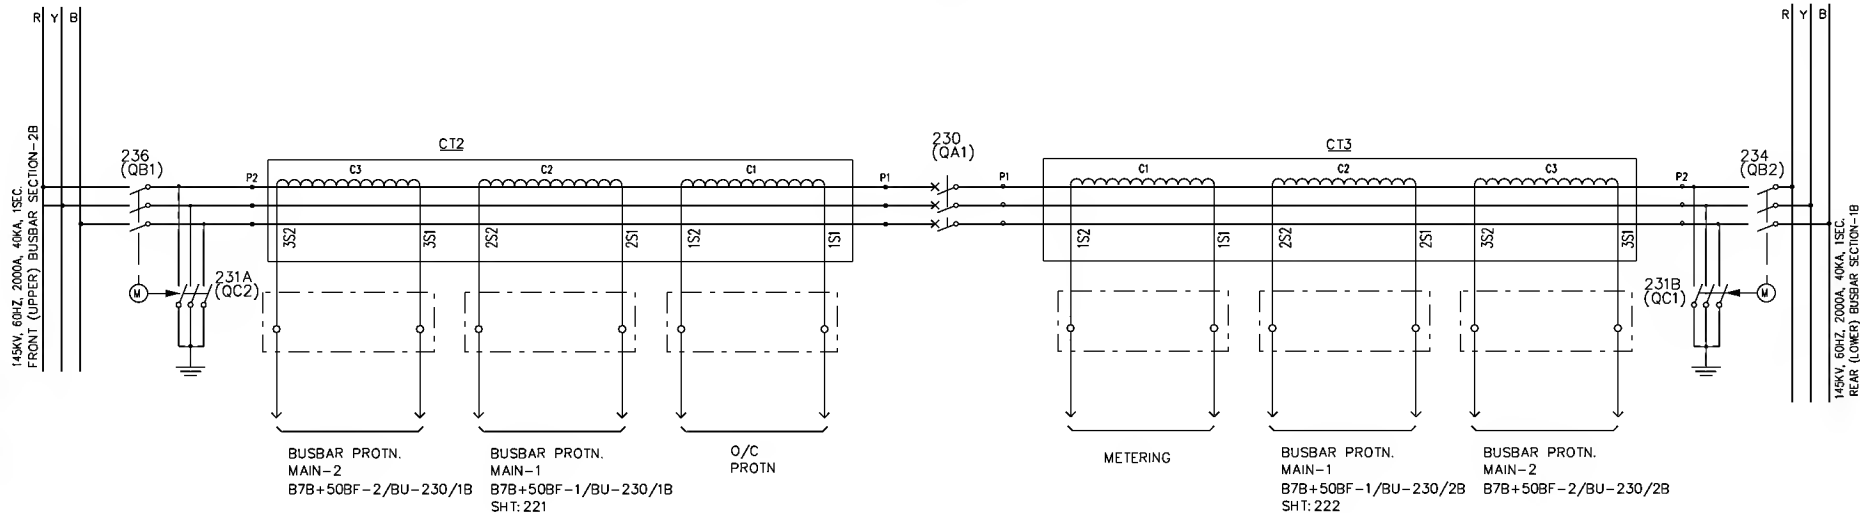

LOCATION OF GIS CT	CT	RATIO	CLASS	VK IN VOLT	Image IN mA @ VK	RCT IN OHMS	BURDEN IN VA	BURDEN IN VA
BUS 1B	CT3 CORE-1	2000/1A	0.2 ISF<10	--	--	--	30	CONTROL IED (BCU) + METERING
	CT3 CORE-2	2000/1A	X	>600 at 2000/1A TAP	< = 25	<5	--	B7B+50BF-1/BU-230/2B MAIN-1
	CT3 CORE-3	2000/1A	X	>600 at 2000/1A TAP	< = 25	<5	--	B7B+50BF-2/BU-230/2B MAIN-2
BUS 2B	CT2 CORE-1	2000/1A	X	>600 at 2000/1A TAP	< = 25	<5	--	50+62BF+50/51+50/51N
	CT2 CORE-2	2000/1A	X	>600 at 2000/1A TAP	< = 25	<5	--	B7B+50BF-1/BU-230/1B MAIN-1
	CT2 CORE-3	2000/1A	X	>600 at 2000/1A TAP	< = 25	<5	--	B7B+50BF-2/BU-230/1B MAIN-2

AS-BUILT BY _____ DATE _____		CONTRACT NO. 1113113/00		JOB ORDER NO. S-13656		PRIMARY SYSTEM BUS COUPLER 230		الشركة الوطنية لنقل الكهرباء		نقل الكهرباء	
01 13 49		FACTORY ASBUILT		DRAWN BY RIZ CHECKED BY KVR		132KV BUSBAR PROTN.MAIN-2 BU PANEL +BBP2-4		National Grid sa			
00 13 05		FOR APPROVAL		DATE STARTED 31.01.2013 DATE COMPLETED _____		S/S 8709 - 132/13.8KV IN AL-KHARJ CITY		INDEX PLANT NO.		DRAWING NUMBER	
REV. NO.		DATE		DESCRIPTION		PRG. DEPT. CTPD ENG. DEPT. AUT-PSAC		- C421		CD-323007	
						RIYADH SAUDI ARABIA		SHEET NO. 052/211		REV. NO. 01	
								NG/D2-D (2012/01)		NGD200	

THIS DRAWING AND THE INFORMATION CONTAINED HEREIN ARE THE SOLE PROPERTY OF National Grid SA. NO REPRODUCTION IN FULL OR IN PART SHALL BE OBTAINED FROM THIS DOCUMENT WITHOUT THE WRITTEN CONSENT OF ITS OWNER.

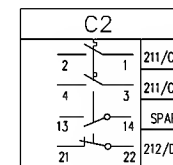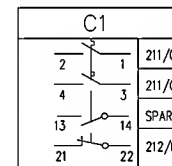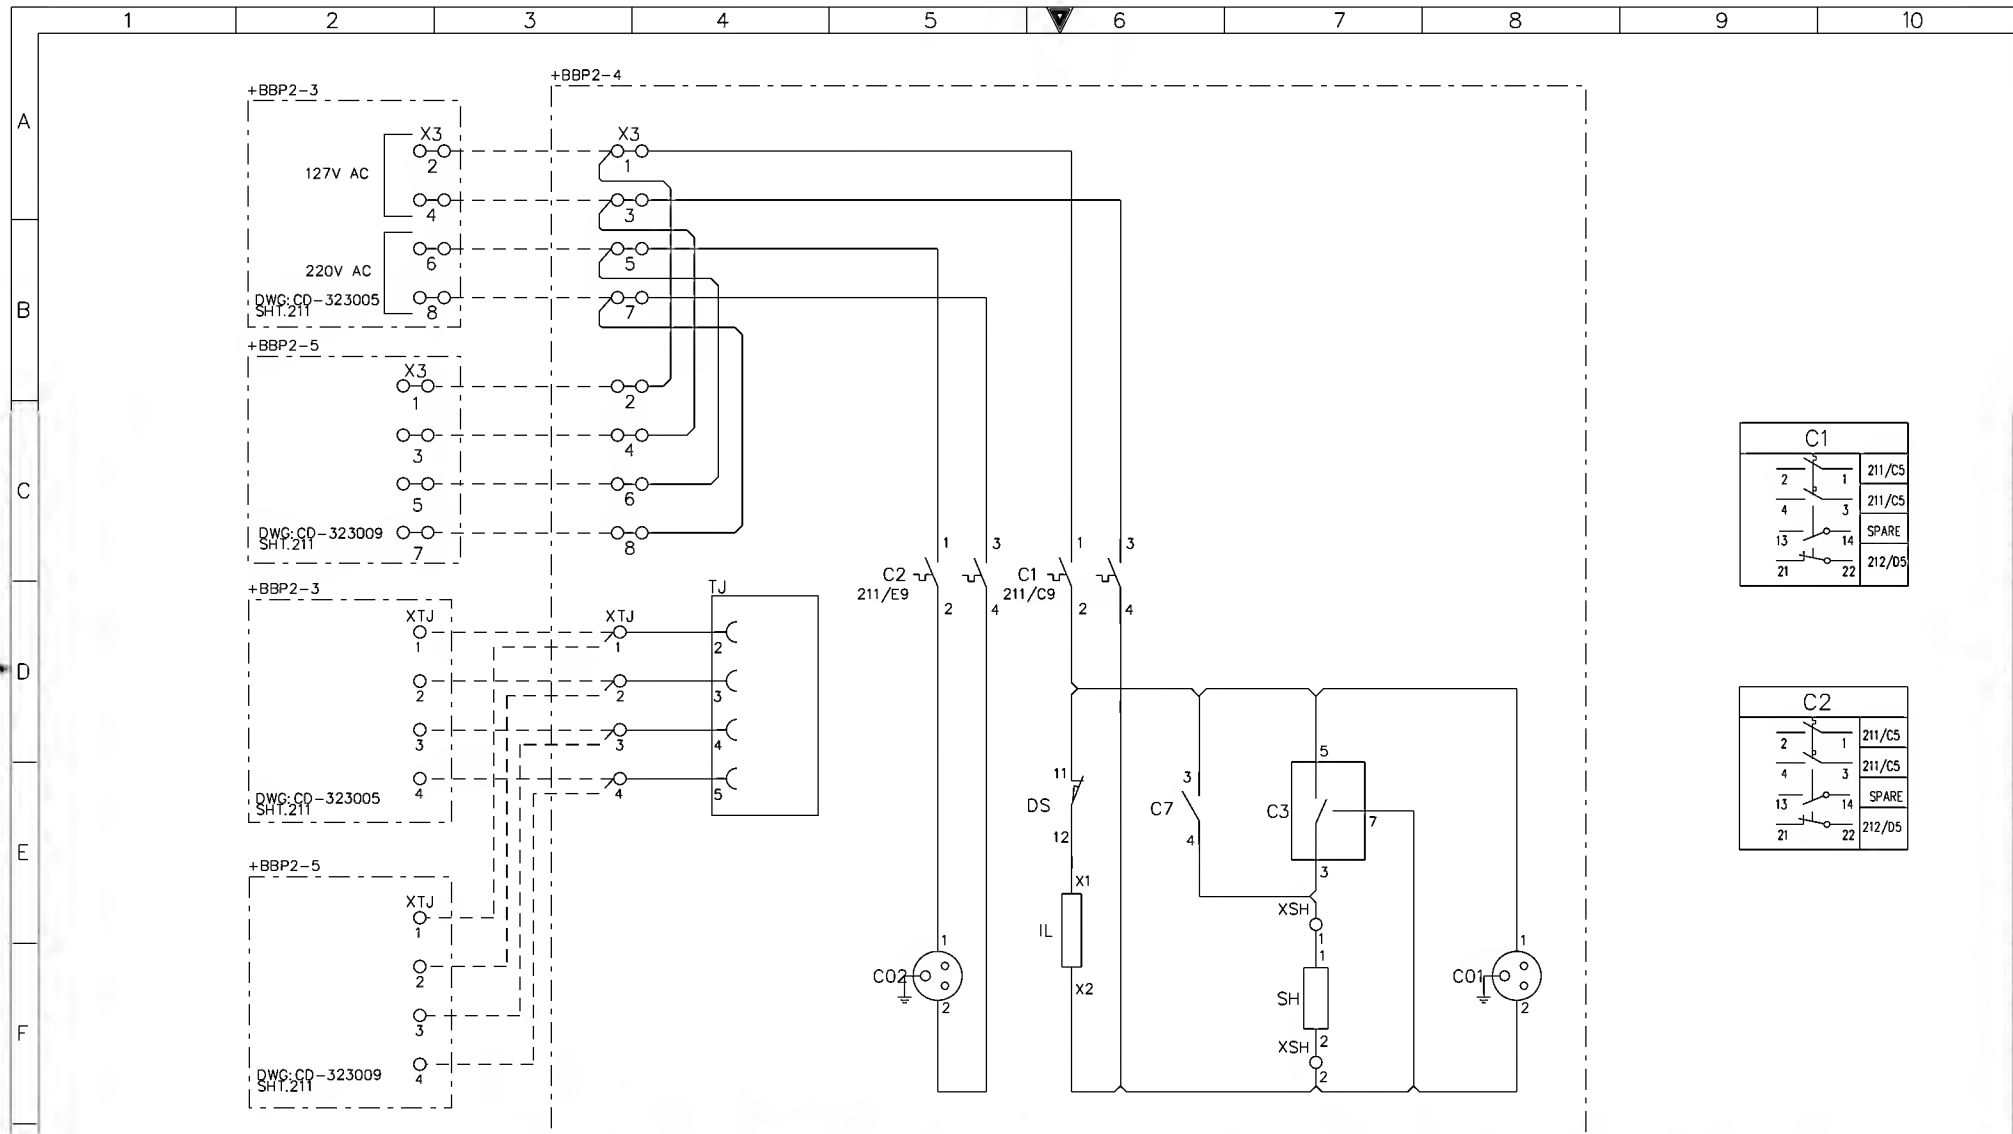

AS-BUILT BY _____ DATE _____ CONTRACT NO. 1113113/00 JOB ORDER NO. S-13656

01 13 49 FACTORY ASBUILT
00 13 05 FOR APPROVAL

DRAWN BY RIZ CHECKED BY KVR
DATE STARTED 31.01.2013 DATE COMPLETED _____
PRG. DEPT. CTPD ENG. DEPT. AUT-PSAC


AC SUPPLY FOR ILLUMINATION & POWER SOCKET
132KV BUSBAR PROTN.MAIN-2 BU PANEL +BBP2-4
S/S 8709 - 132/13.8KV IN AL-KHARJ CITY
RIYADH SAUDI ARABIA

الشركة الوطنية لنقل الكهرباء




نقل الكهرباء
National Grid sa

INDEX	PLANT NO.	DRAWING NUMBER	SHEET NO.	REV. NO.
-	C421	CD-323007	211 212	01


NG/D2-0 (2012/01)
VECTOR NGD200

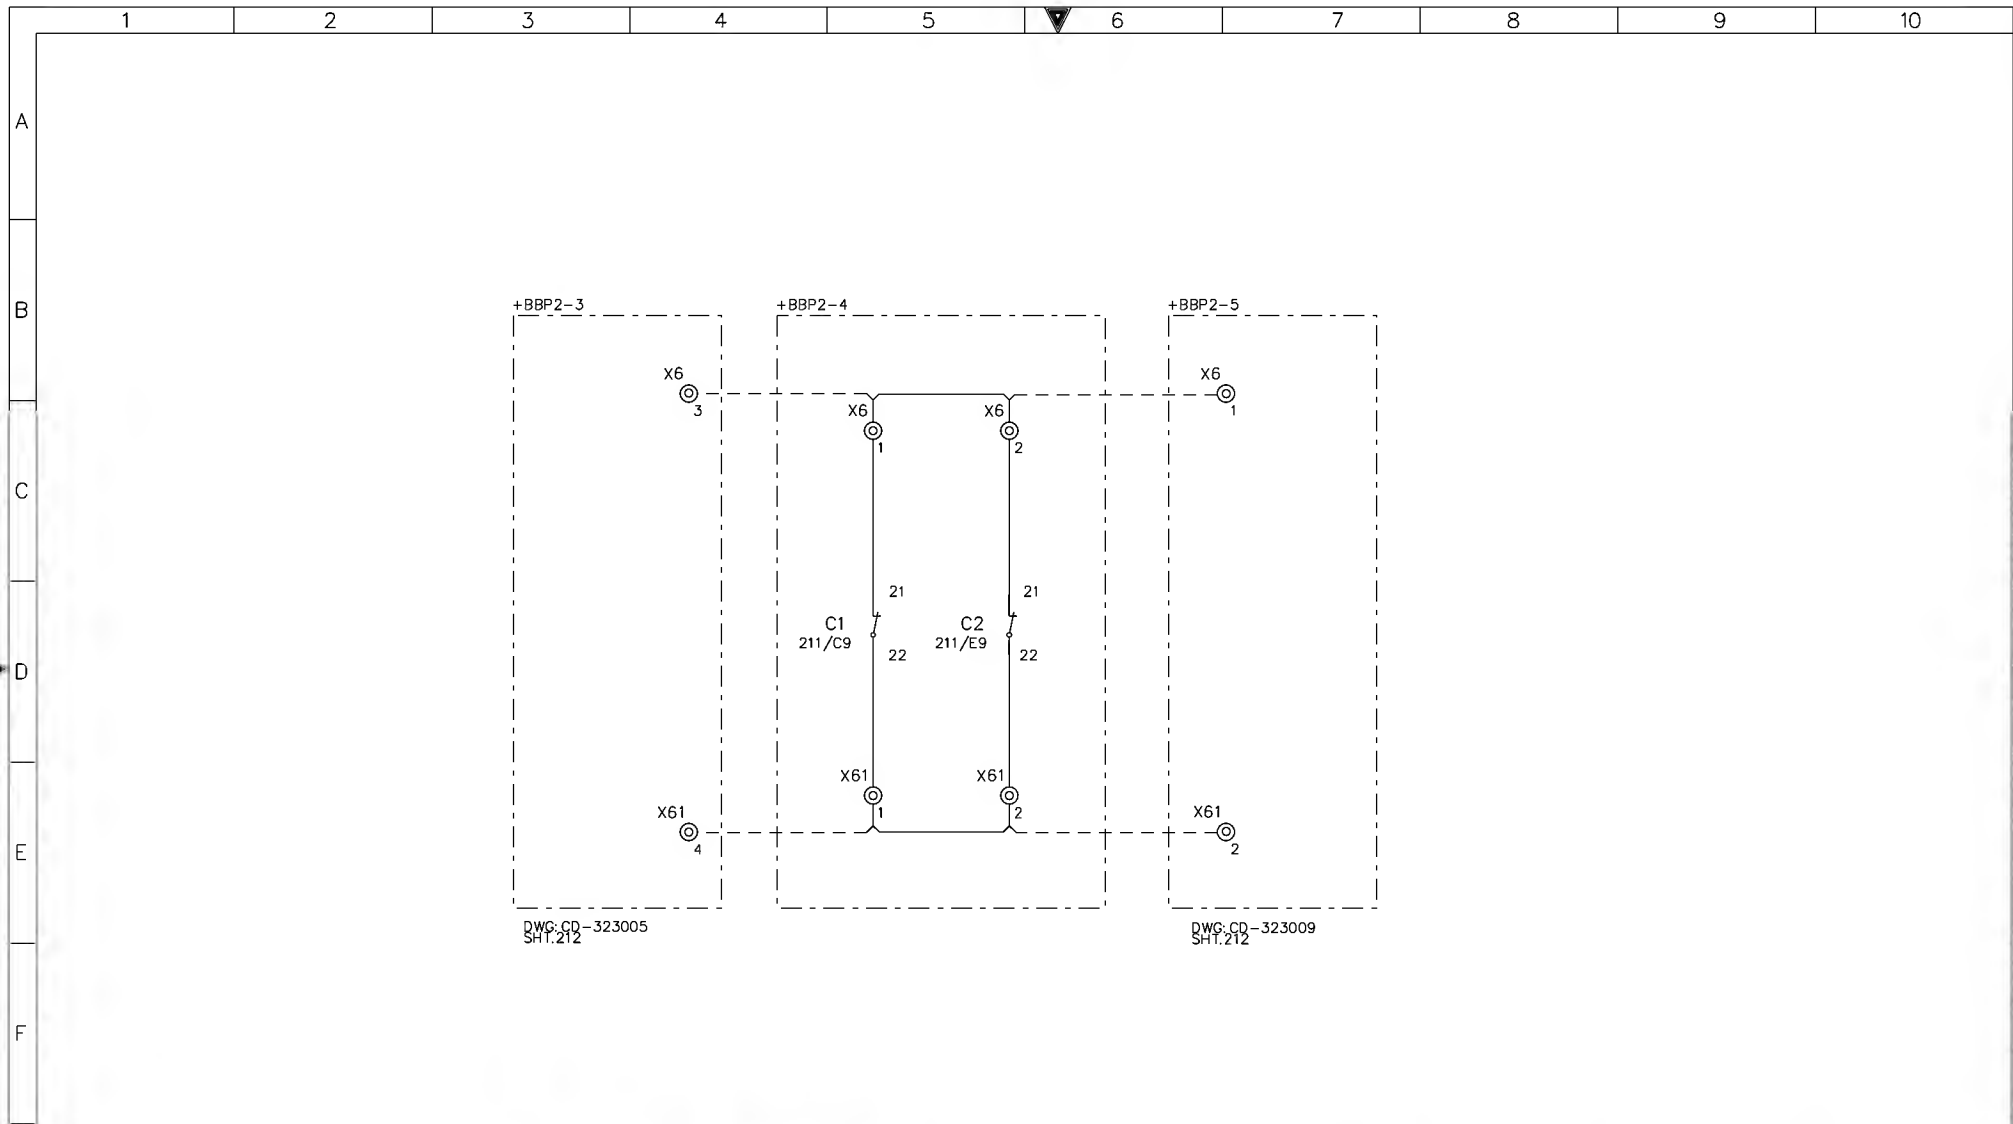

AS-BUILT BY _____ DATE _____			CONTRACT NO. 11131113/00		JOB ORDER NO. S-13656		CUB.LIGHTING,HEATER&SOKET ALARM CKT.				الشركة الوطنية لنقل الكهرباء			
DRAWN BY RIZ			CHECKED BY KVR		DATE STARTED 31.01.2013		DATE COMPLETED _____		132KV BUSBAR PROTN.MAIN-2 BU PANEL +BBP2-4		National Grid sa			
FACTORY ASBUILT			DATE STARTED 31.01.2013		DATE COMPLETED _____		S/S 8709 - 132/13.8KV IN AL-KHARJ CITY		INDEX		PLANT NO.		DRAWING NUMBER	
FOR APPROVAL			PRG. DEPT. CTPD		ENG. DEPT. AUT-PSAC		RIYADH		- C421		CD-323007		SHEET NO.	
REV. NO.			DATE		DESCRIPTION		SAUDI ARABIA		212 216		212 216		REV. NO.	
													01	
													NG/D2-0 (2012/01)	
													DMS	
													VECTOR	
													NGD200	

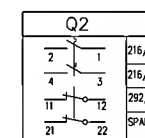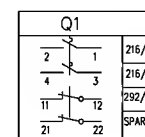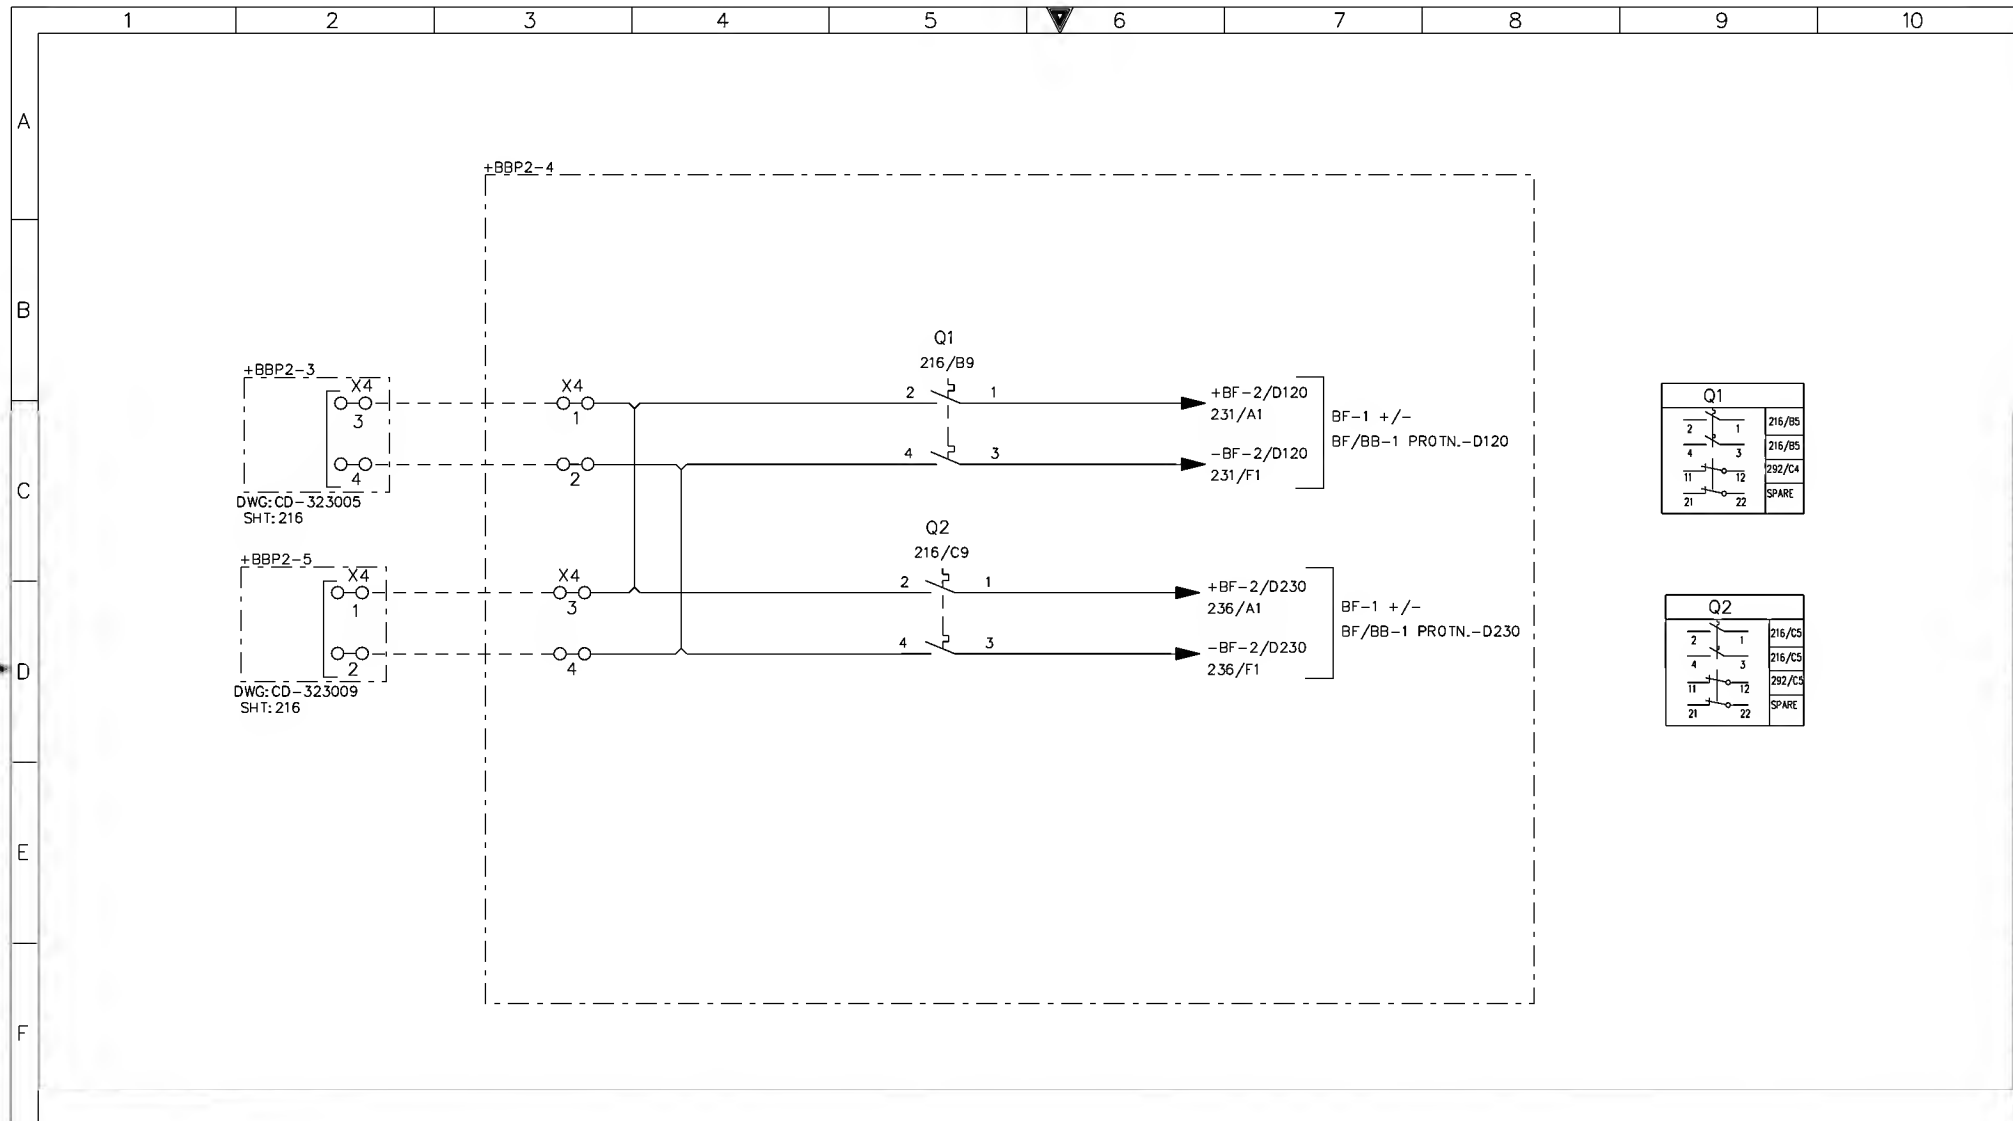


AS-BUILT BY _____ DATE _____			CONTRACT NO. 1113113/00		JOB ORDER NO. S-13656		DC SUPPLY DISTRIBUTION		الشركة الوطنية لنقل الكهرباء		نقل الكهرباء	
DRAWN BY RIZ CHECKED BY KVR			DATE STARTED 31.01.2013 DATE COMPLETED _____		132KV BUSBAR PROTN.MAIN-2 BU PANEL +BBP2-4		S/S 8709 - 132/13.8KV IN AL-KHARJ CITY		National Grid sa		SHEET NO.	
FOR APPROVAL			OPRG. DEPT. CTPD ENG. DEPT. AUT-PSAC		RIYADH SAUDI ARABIA		INDEX PLANT NO. C421		DRAWING NUMBER CD-323007		SHT CONT.	
REV. NO. 01			DATE 13 05		DESCRIPTION		-		216		221	
											REV. NO. 01	

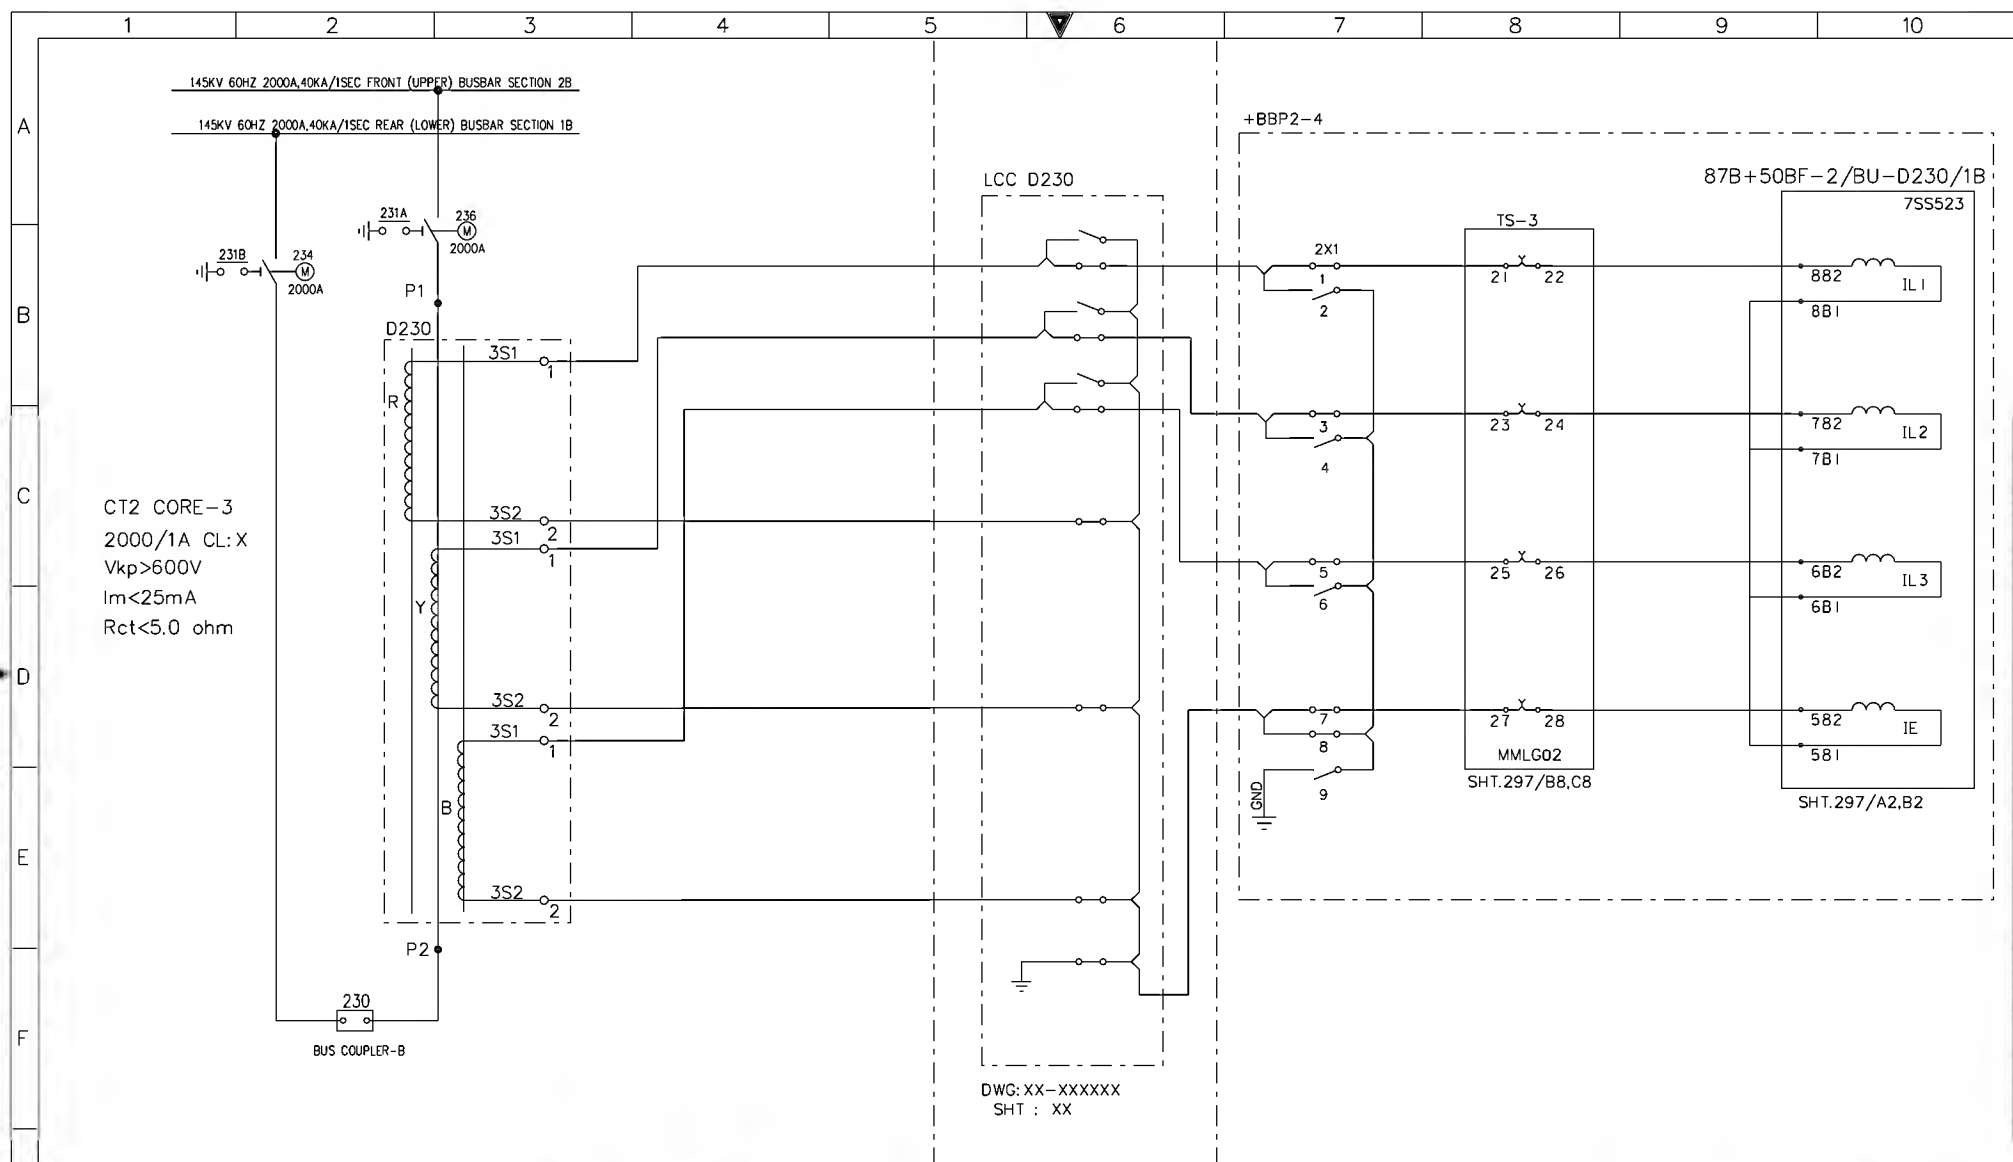

AS-BUILT BY _____ DATE _____			CONTRACT NO. 1113113/00		JOB ORDER NO. S-13656		CURRENT TRANSFORMER INPUTS -87B+50BF-2/BU-D230/1B		
01 13 49			DRAWN BY RIZ		CHECKED BY KVR		132KV BUSBAR PROTN,MAIN-2 BU PANEL +BBP2-4		
00 13 05			DATE STARTED 31.01.2013		DATE COMPLETED _____		S/S 8709 - 132/13.8KV IN AL-KHARJ CITY		
REV. NO. _____			OPRG. DEPT. CTPD		ENG. DEPT. AUT-PSAC		RIYADH SAUDI ARABIA		
FACTORY ASBUILT			FOR APPROVAL				INDEX PLANT NO. DRAWING NUMBER SHEET NO. REV. NO.		
							- C421 CD-323007 223/224 01		
							NG/D2-0 (2012/01)		
							DMS VECTOR NGD200		

THIS DRAWING AND THE INFORMATION CONTAINED HEREIN ARE THE SOLE PROPERTY OF NATIONAL GRID SA. NO REPRODUCTION IN FULL OR IN PART SHALL BE OBTAINED FROM THIS DOCUMENT WITHOUT THE WRITTEN CONSENT OF ITS OWNER.

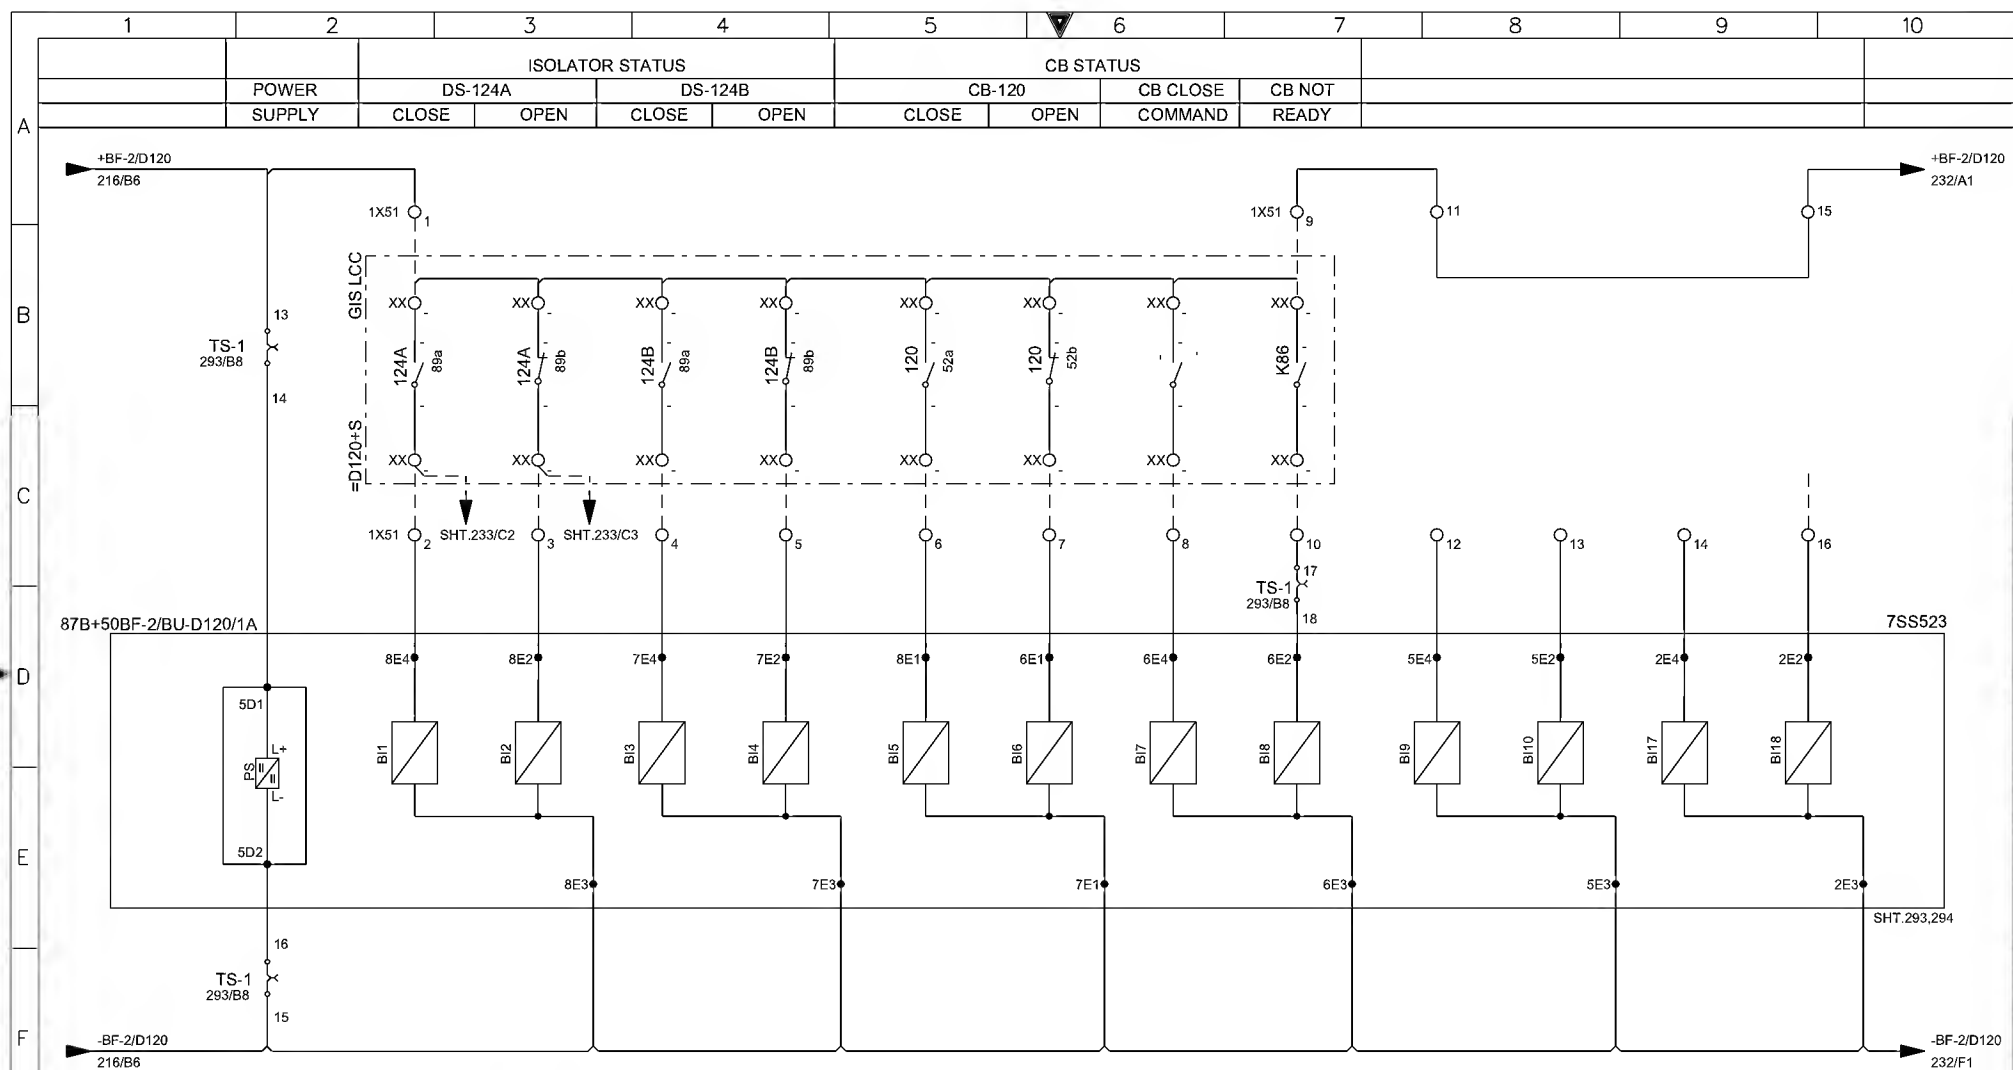


AS-BUILT BY _____ DATE _____		CONTRACT NO. 1113113/00		JOB ORDER NO. S-13656		87B+50BF-2/BU-D120/1A PROTN.RELAY - BINARY INPUTS		132KV BUSBAR PROTN.MAIN-2 BU PANEL +BBP2-4		S/S 8709 - 132/13.8KV IN AL-KHARJ CITY		RIYADH SAUDI ARABIA		INDEX PLANT NO. DRAWING NUMBER SHEET NO. REV. NO.		- C421 CD-323007 231 232 01	
01	13 49	FACTORY ASBUILT		DRAWN BY RIZ CHECKED BY KVR		132KV BUSBAR PROTN.MAIN-2 BU PANEL +BBP2-4		S/S 8709 - 132/13.8KV IN AL-KHARJ CITY		RIYADH SAUDI ARABIA		INDEX PLANT NO. DRAWING NUMBER SHEET NO. REV. NO.		- C421 CD-323007 231 232 01		NG/D2-0 (2012/01)	
00	13 05	FOR APPROVAL		DATE STARTED 31.01.2013 DATE COMPLETED _____		S/S 8709 - 132/13.8KV IN AL-KHARJ CITY		RIYADH SAUDI ARABIA		INDEX PLANT NO. DRAWING NUMBER SHEET NO. REV. NO.		- C421 CD-323007 231 232 01		NG/D2-0 (2012/01)		NGD200	
REV. NO.	DATE	DESCRIPTION		OPRG. DEPT. CTPD ENG. DEPT. AUT-PSAC		S/S 8709 - 132/13.8KV IN AL-KHARJ CITY		RIYADH SAUDI ARABIA		INDEX PLANT NO. DRAWING NUMBER SHEET NO. REV. NO.		- C421 CD-323007 231 232 01		NG/D2-0 (2012/01)		NGD200	

الشركة الوطنية لنقل الكهرباء
National Grid sa


NG/D2-0 (2012/01)
NGD200

THIS DRAWING AND THE INFORMATION CONTAINED HEREIN ARE THE SOLE PROPERTY OF National Grid SA. NO REPRODUCTION IN FULL OR IN PART SHALL BE OBTAINED FROM THIS DOCUMENT WITHOUT THE WRITTEN CONSENT OF ITS OWNER.

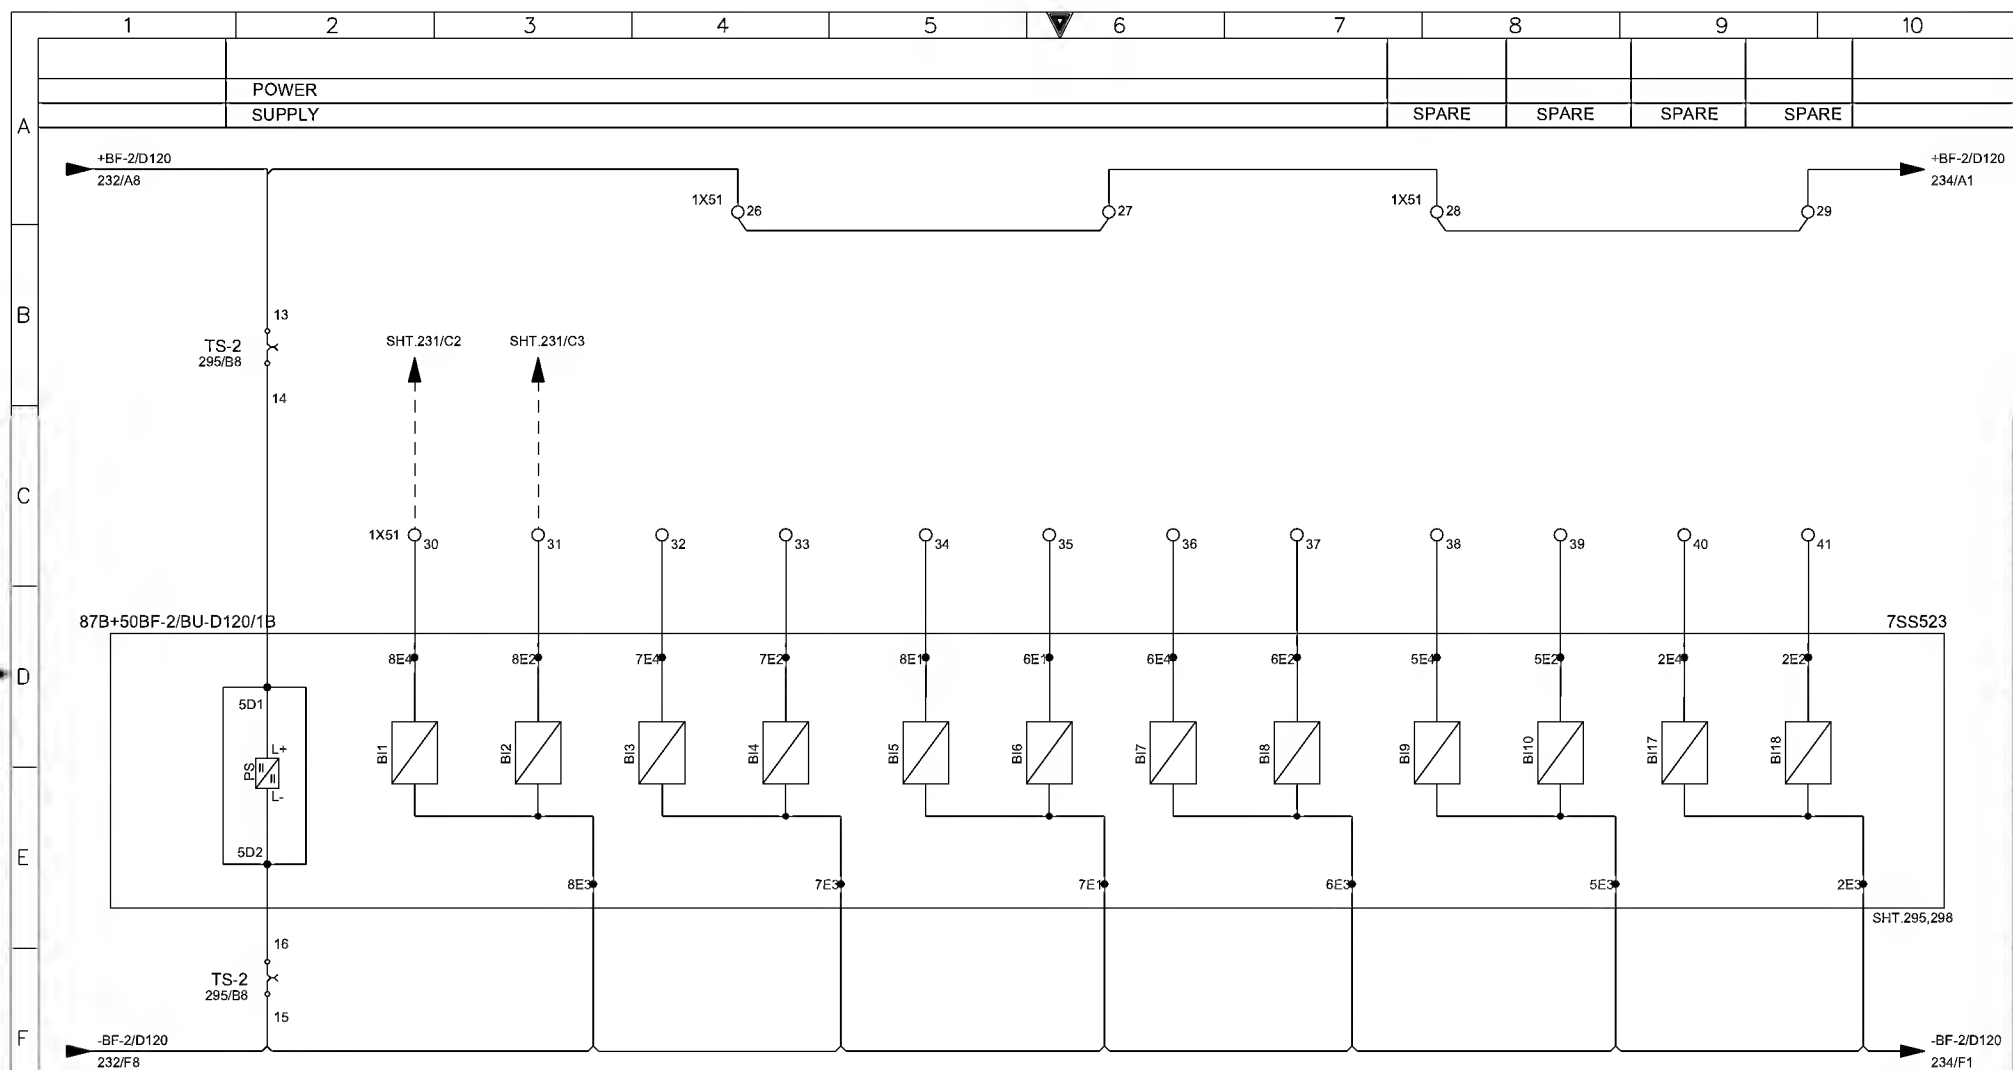

AS-BUILT BY _____ DATE _____		CONTRACT NO. 1113113/00	JOB ORDER NO. S-13656	87B+50BF-2/BU-D120/1B PROTN.RELAY - BINARY INPUTS		الشركة الوطنية لنقل الكهرباء		نقل الكهرباء	
01	13 49	FACTORY ASBUILT FOR APPROVAL	DRAWN BY RIZ CHECKED BY KVR	132KV BUSBAR PROTN.MAIN-2 BU PANEL +BBP2-4		INDEX	PLANT NO.	DRAWING NUMBER	SHEET NO.
00	13 05		DATE STARTED 31.01.2013 DATE COMPLETED _____	S/S 8709 - 132/13.8KV IN AL-KHARJ CITY					
REV. NO.	DATE	DESCRIPTION	OPRG. DEPT. CTPD ENG. DEPT. AUT-PSAC	RIYADH SAUDI ARABIA		-	C421	CD-323007	SHT 1 CONT.
								233/234	

THIS DRAWING AND THE INFORMATION CONTAINED HEREIN ARE THE SOLE PROPERTY OF National Grid SA. NO REPRODUCTION IN FULL OR IN PART SHALL BE OBTAINED FROM THIS DOCUMENT WITHOUT THE WRITTEN CONSENT OF ITS OWNER.

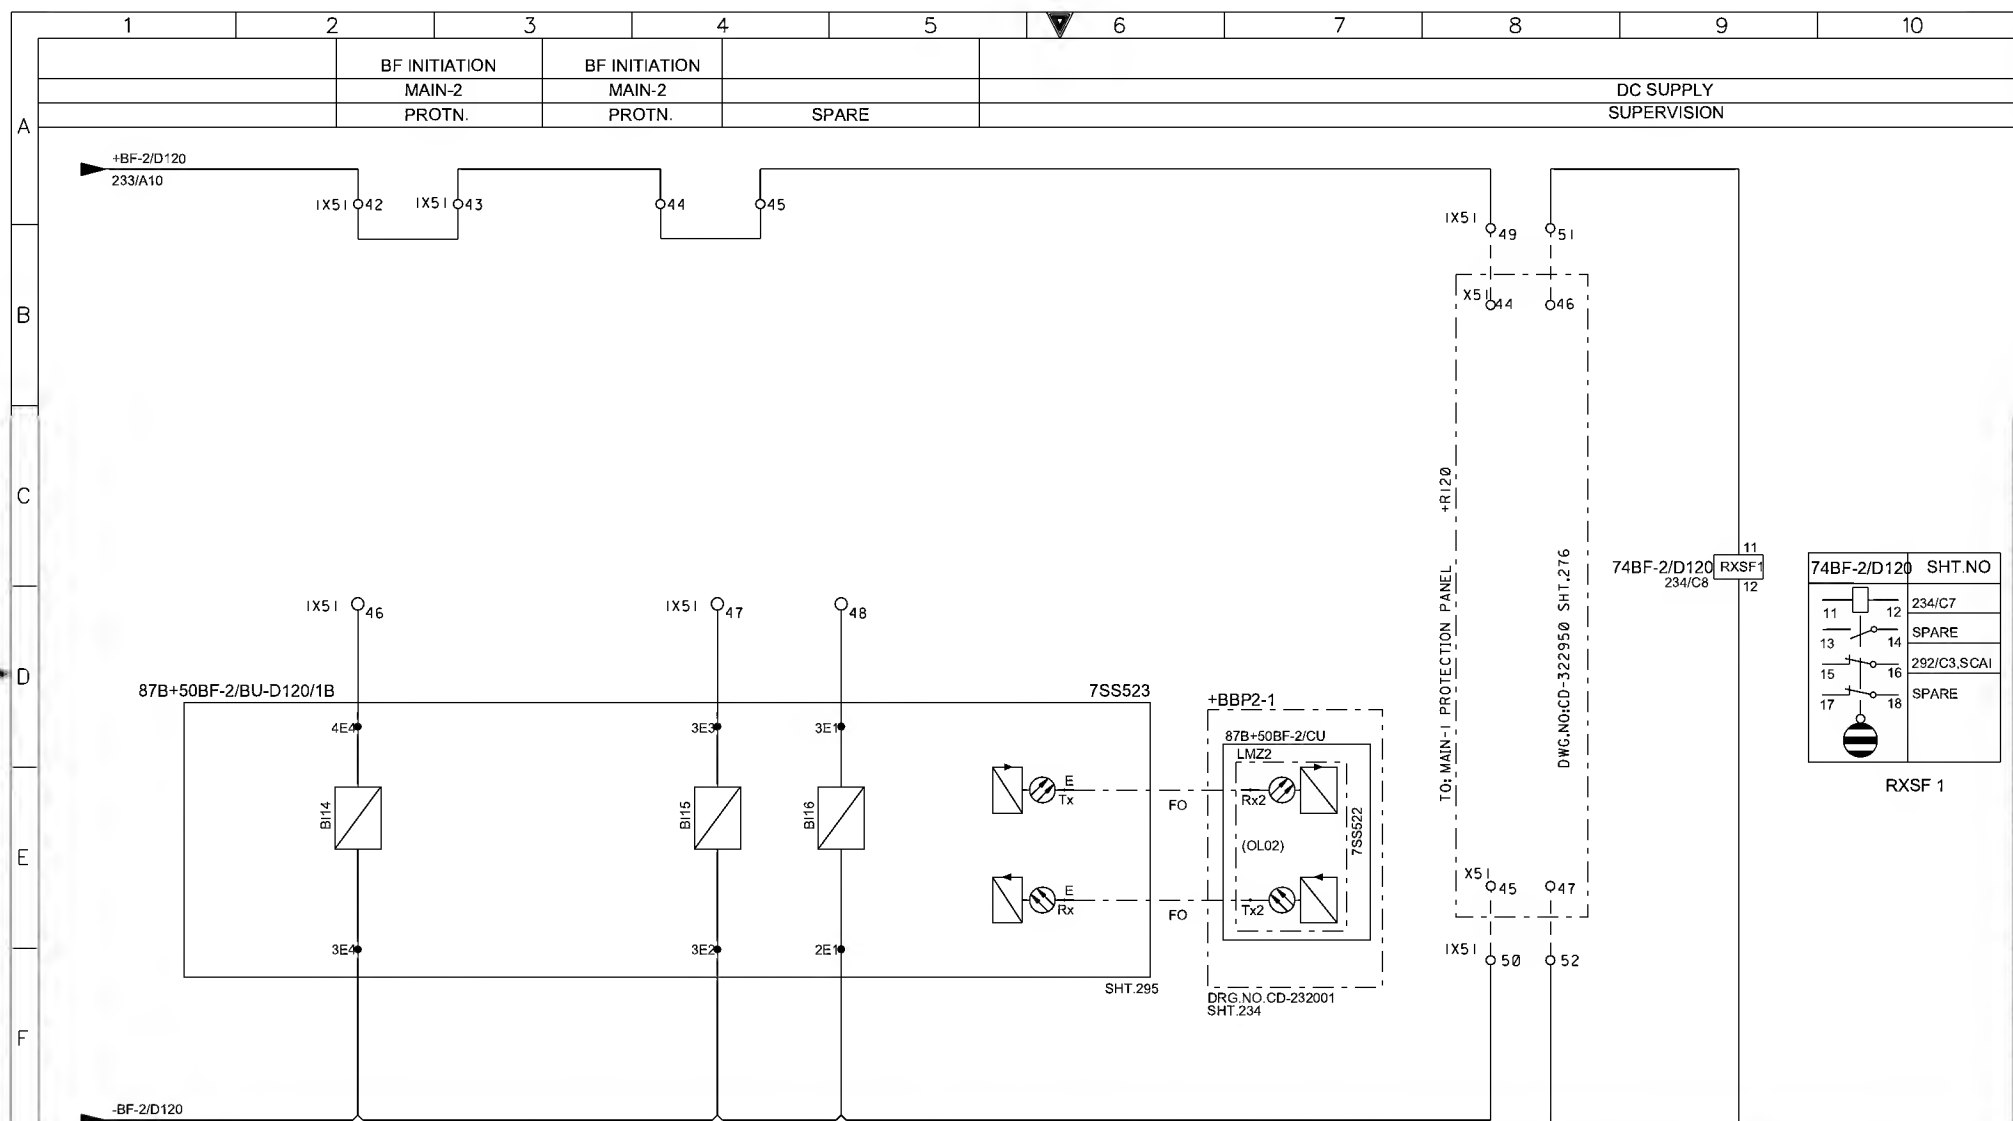

74BF-2/D120	SHT.NO
11	234/C7
12	SPARE
13	292/C3.SCAI
14	SPARE
15	
16	
17	
18	

RXSF 1

AS-BUILT BY _____ DATE _____ CONTRACT NO. 1113113/00 JOB ORDER NO. S-13656

01	13 49	FACTORY ASBUILT
00	13 05	FOR APPROVAL

DRAWN BY RIZ CHECKED BY KVR
 DATE STARTED 31.01.2013 DATE COMPLETED _____
 PRG. DEPT. CTPD ENG. DEPT. AUT-PSAC


87B+50BF-2/BU-D120/1B PROTN.RELAY - BINARY INPUTS
 132KV BUSBAR PROTN.MAIN-2 BU PANEL +BBP2-4
 S/S 8709 - 132/13.8KV IN AL-KHARJ CITY
 RIYADH SAUDI ARABIA

الشركة الوطنية لنقل الكهرباء




INDEX	PLANT NO.	DRAWING NUMBER	SHEET NO.	REV. NO.
-	C421	CD-323007	234/235	01

NG/D2-D (2012/01)
 DMS VECTOR NGD200

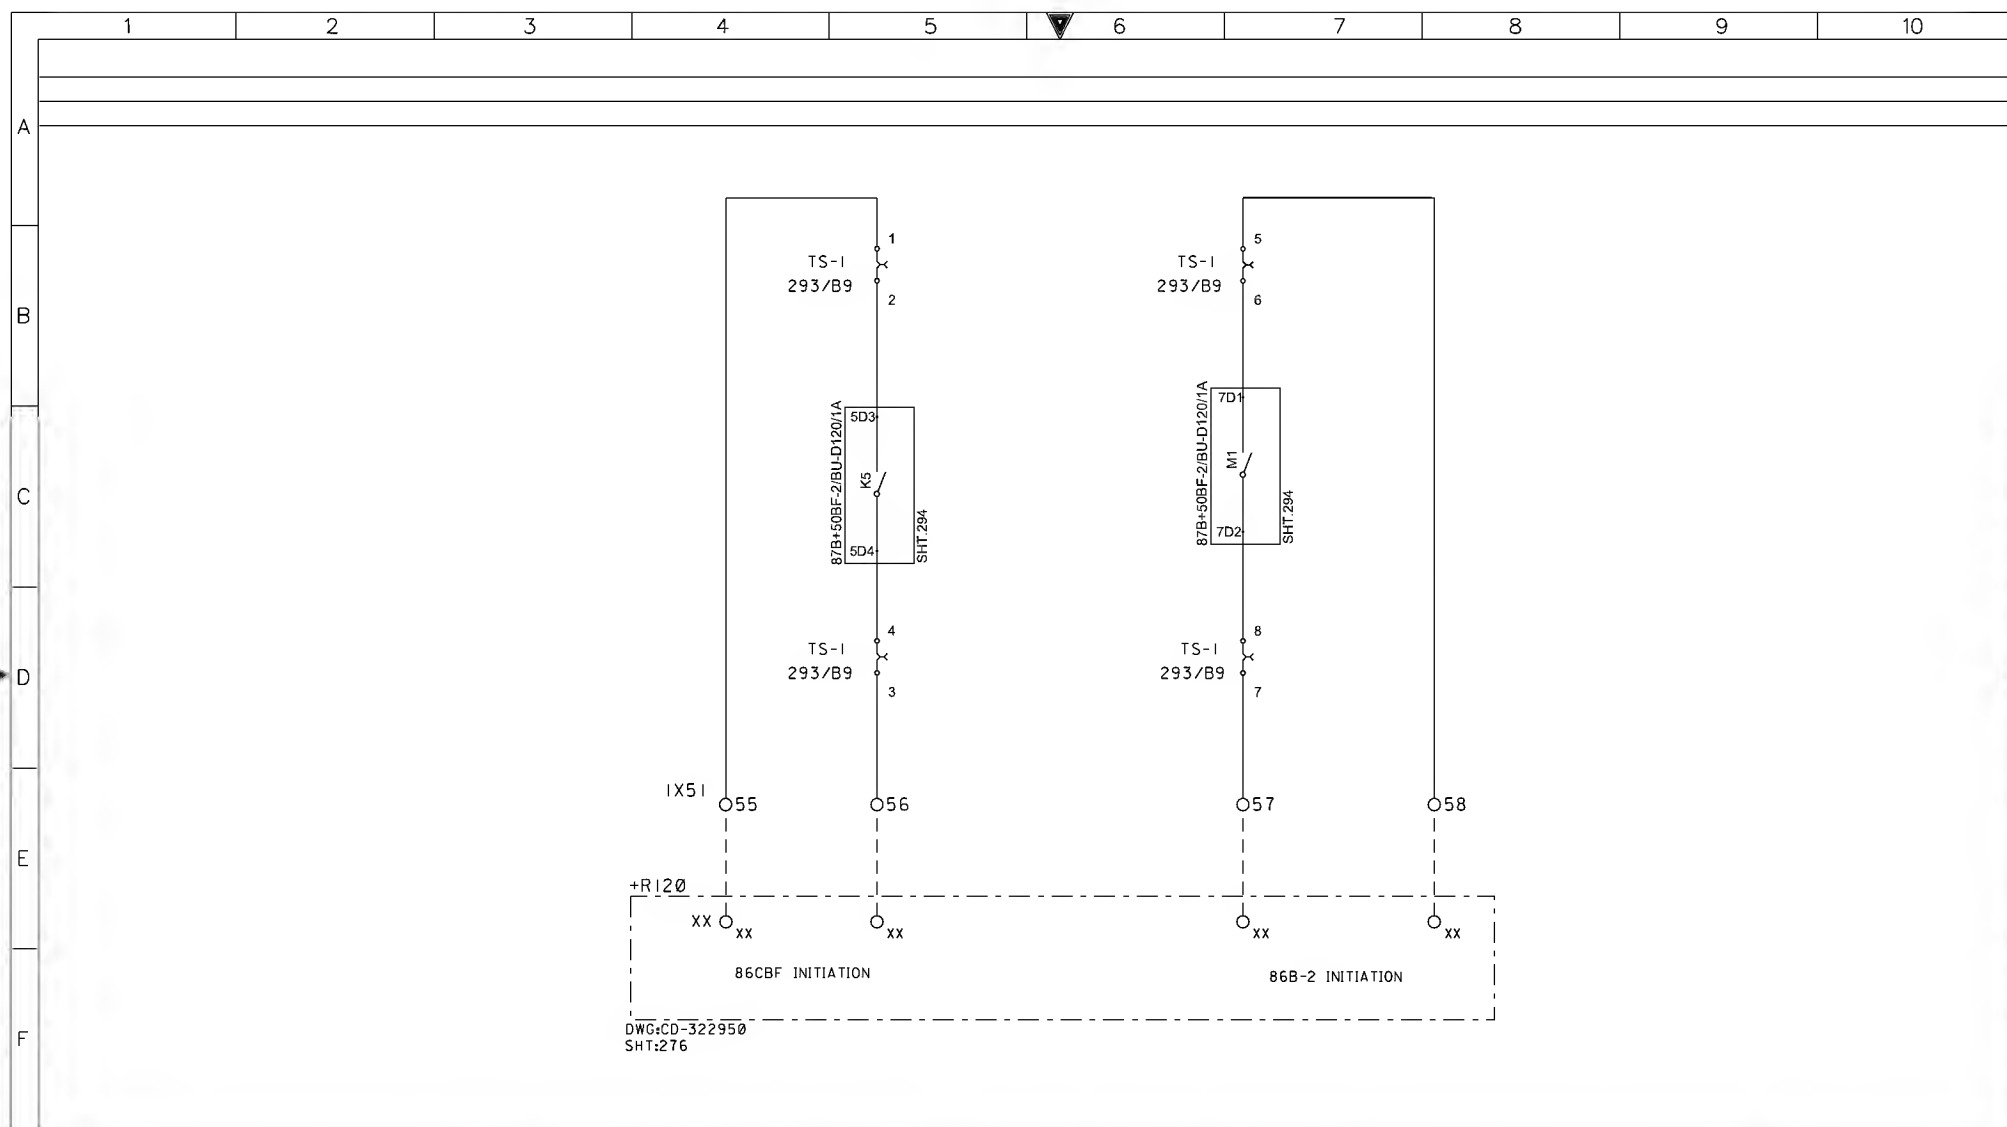

AS-BUILT BY _____ DATE _____			CONTRACT NO. 11131113/00		JOB ORDER NO. S-13656		CBF + BUSBAR PROTN-2 TRIP RELAY CIRCUIT -D120			الشركة الوطنية لنقل الكهرباء			
DRAWN BY RIZ CHECKED BY KVR			DATE STARTED 31.01.2013		DATE COMPLETED _____		132KV BUSBAR PROTN.MAIN-2 BU PANEL +BBP2-4			National Grid sa			
FOR APPROVAL			OPRG. DEPT. CTPD		ENG. DEPT. AUT-PSAC		S/S 8709 - 132/13.8KV IN AL-KHARJ CITY			INDEX PLANT NO. DRAWING NUMBER SHEET NO. REV. NO.			
REV. NO.	DATE	DESCRIPTION	RIYADH		SAUDI ARABIA		-	C421	CD-323007	235	236	01	


THIS DRAWING AND THE INFORMATION CONTAINED HEREIN ARE THE SOLE PROPERTY OF National Grid sa. NO REPRODUCTION IN FULL OR IN PART SHALL BE OBTAINED FROM THIS DOCUMENT WITHOUT THE WRITTEN CONSENT OF ITS OWNER.

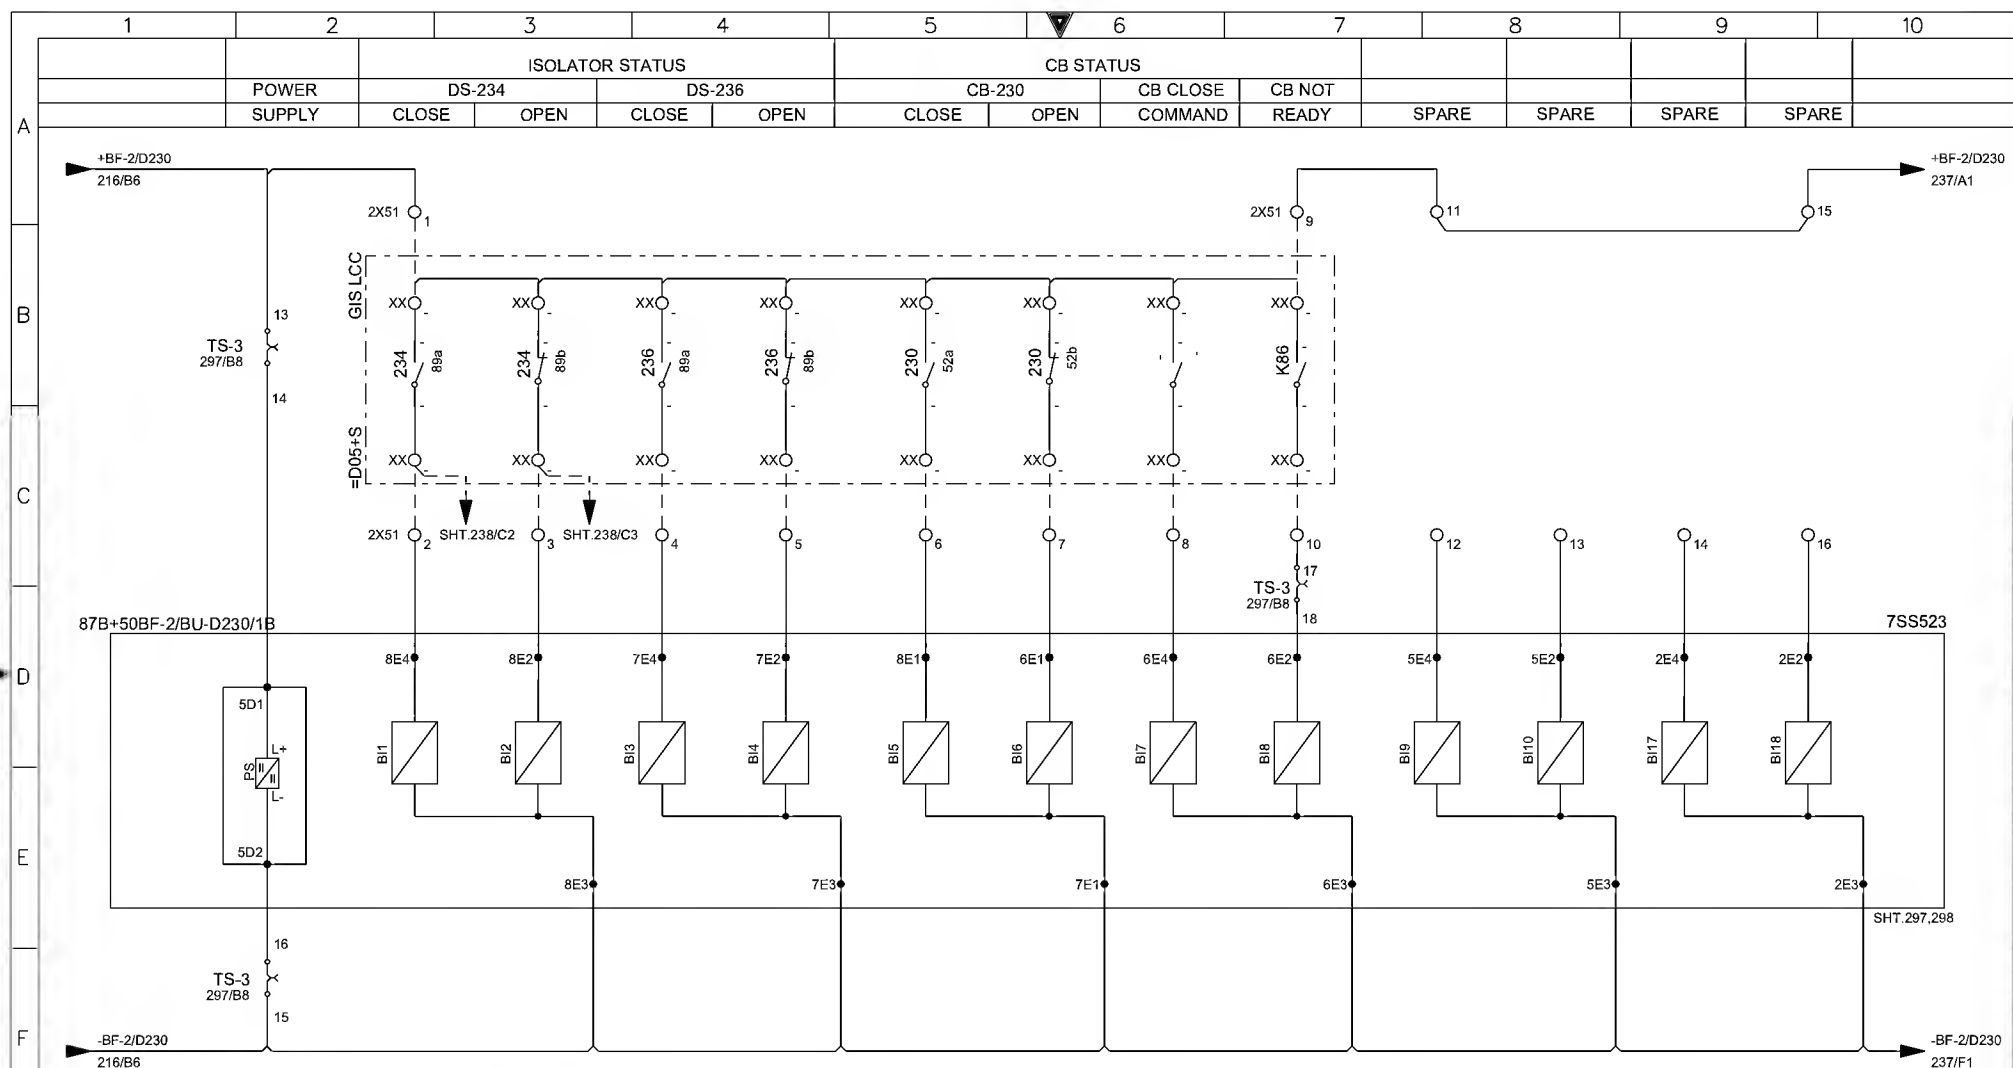

AS-BUILT BY _____ DATE _____		CONTRACT NO. 1113113/00		JOB ORDER NO. S-13656		87B+50BF-2/BU-D230/1B PROTN.RELAY - BINARY INPUTS		الشركة الوطنية لنقل الكهرباء		نقل الكهرباء	
01 13 49		FACTORY ASBUILT		DRAWN BY RIZ CHECKED BY KVR		132KV BUSBAR PROTN.MAIN-2 BU PANEL +BBP2-4		INDEX		PLANT NO.	
00 13 05		FOR APPROVAL		DATE STARTED 31.01.2013 DATE COMPLETED _____		S/S 8709 - 132/13.8KV IN AL-KHARJ CITY		DRAWING NUMBER		SHEET NO.	
REV. NO.		DATE		DESCRIPTION		PRG. DEPT. CTPD ENG. DEPT. AUT-PSAC		CD-323007		SHT. CDNT.	
						RIYADH SAUDI ARABIA		- C421		236/237	
										01	


NG/D2-0 (2012/01)
DMS VECTOR NGD200

THIS DRAWING AND THE INFORMATION CONTAINED HEREIN ARE THE SOLE PROPERTY OF National Grid SA. NO REPRODUCTION IN FULL OR IN PART SHALL BE OBTAINED FROM THIS DOCUMENT WITHOUT THE WRITTEN CONSENT OF ITS OWNER.

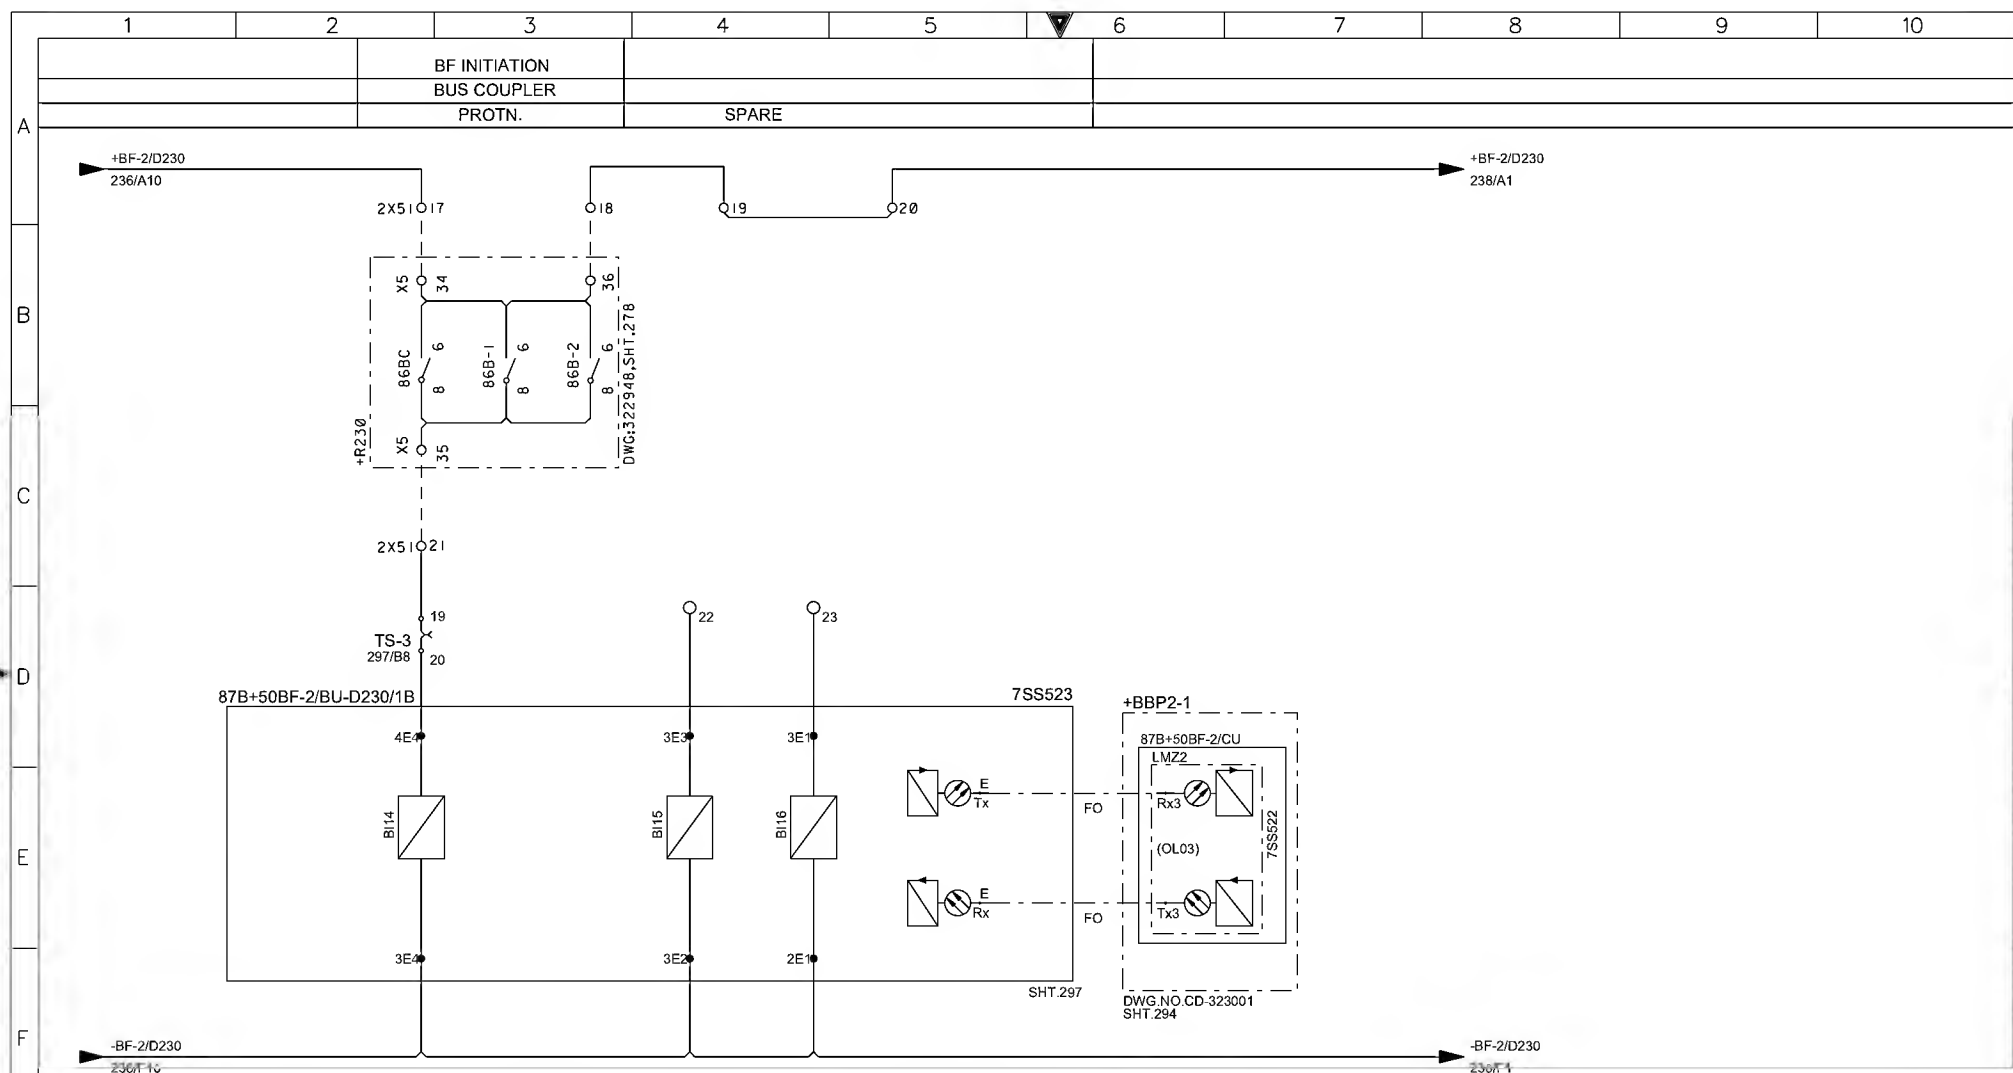

AS-BUILT BY _____ DATE _____			CONTRACT NO. 1113113/00		JOB ORDER NO. S-13656		87B+50BF-2/BU-D230/1B PROTN.RELAY - BINARY INPUTS		
01	13 49	FACTORY ASBUILT	DRAWN BY RIZ		CHECKED BY KVR		132KV BUSBAR PROTN.MAIN-2 BU PANEL +BBP2-4		
00	13 05	FOR APPROVAL	DATE STARTED 31.01.2013		DATE COMPLETED _____		S/S 8709 - 132/13.8KV IN AL-KHARJ CITY		
REV. NO.	DATE	DESCRIPTION	OPRG. DEPT. CTPD		ENG. DEPT. AUT-PSAC		RIYADH SAUDI ARABIA		

INDEX	PLANT NO.	DRAWING NUMBER	SHEET NO.	REV. NO.
-	C421	CD-323007	237/238	01

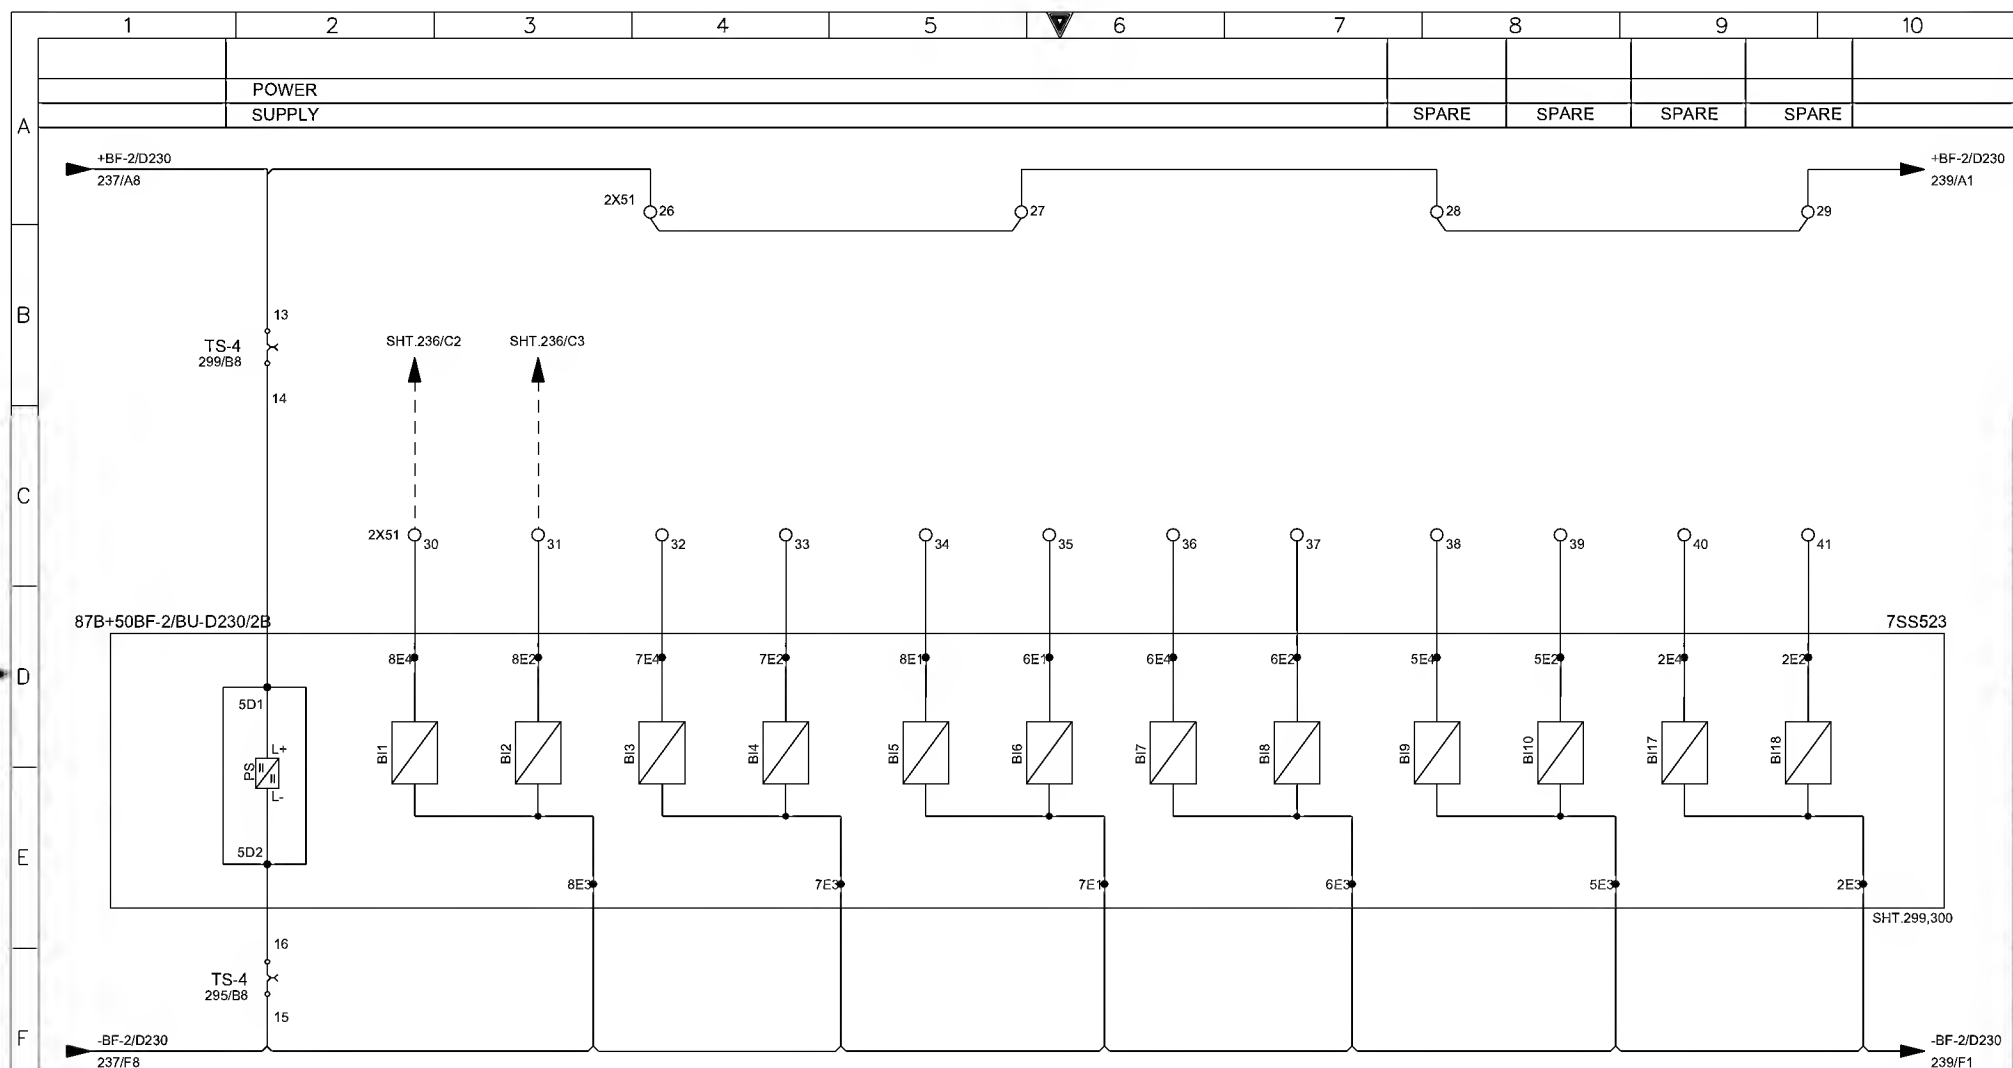


AS-BUILT BY _____ DATE _____		CONTRACT NO. 11131113/00	JOB ORDER NO. S-13656	87B+50BF-2/BU-D230/2B PROTN.RELAY - BINARY INPUTS	
01	13 49	FACTORY ASBUILT FOR APPROVAL	DRAWN BY RIZ CHECKED BY KVR	132KV BUSBAR PROTN.MAIN-2 BU PANEL +BBP2-4	
00	13 05		DATE STARTED 31.01.2013 DATE COMPLETED _____	S/S 8709 - 132/13.8KV IN AL-KHARJ CITY	
REV. NO.	DATE	DESCRIPTION	OPRG. DEPT. CTPD ENG. DEPT. AUT-PSAC	RIYADH	SAUDI ARABIA

الشركة الوطنية لنقل الكهرباء		نقل الكهرباء	
National Grid sa		National Grid sa	
INDEX	PLANT NO.	DRAWING NUMBER	SHEET NO.
-	C421	CD-323007	238/239
			REV. NO. 01

NG/D2-0 (2012/01)
DMS VECTOR NGD200

THIS DRAWING AND THE INFORMATION CONTAINED HEREIN ARE THE SOLE PROPERTY OF National Grid sa. NO REPRODUCTION IN FULL OR IN PART SHALL BE OBTAINED FROM THIS DOCUMENT WITHOUT THE WRITTEN CONSENT OF ITS OWNER.

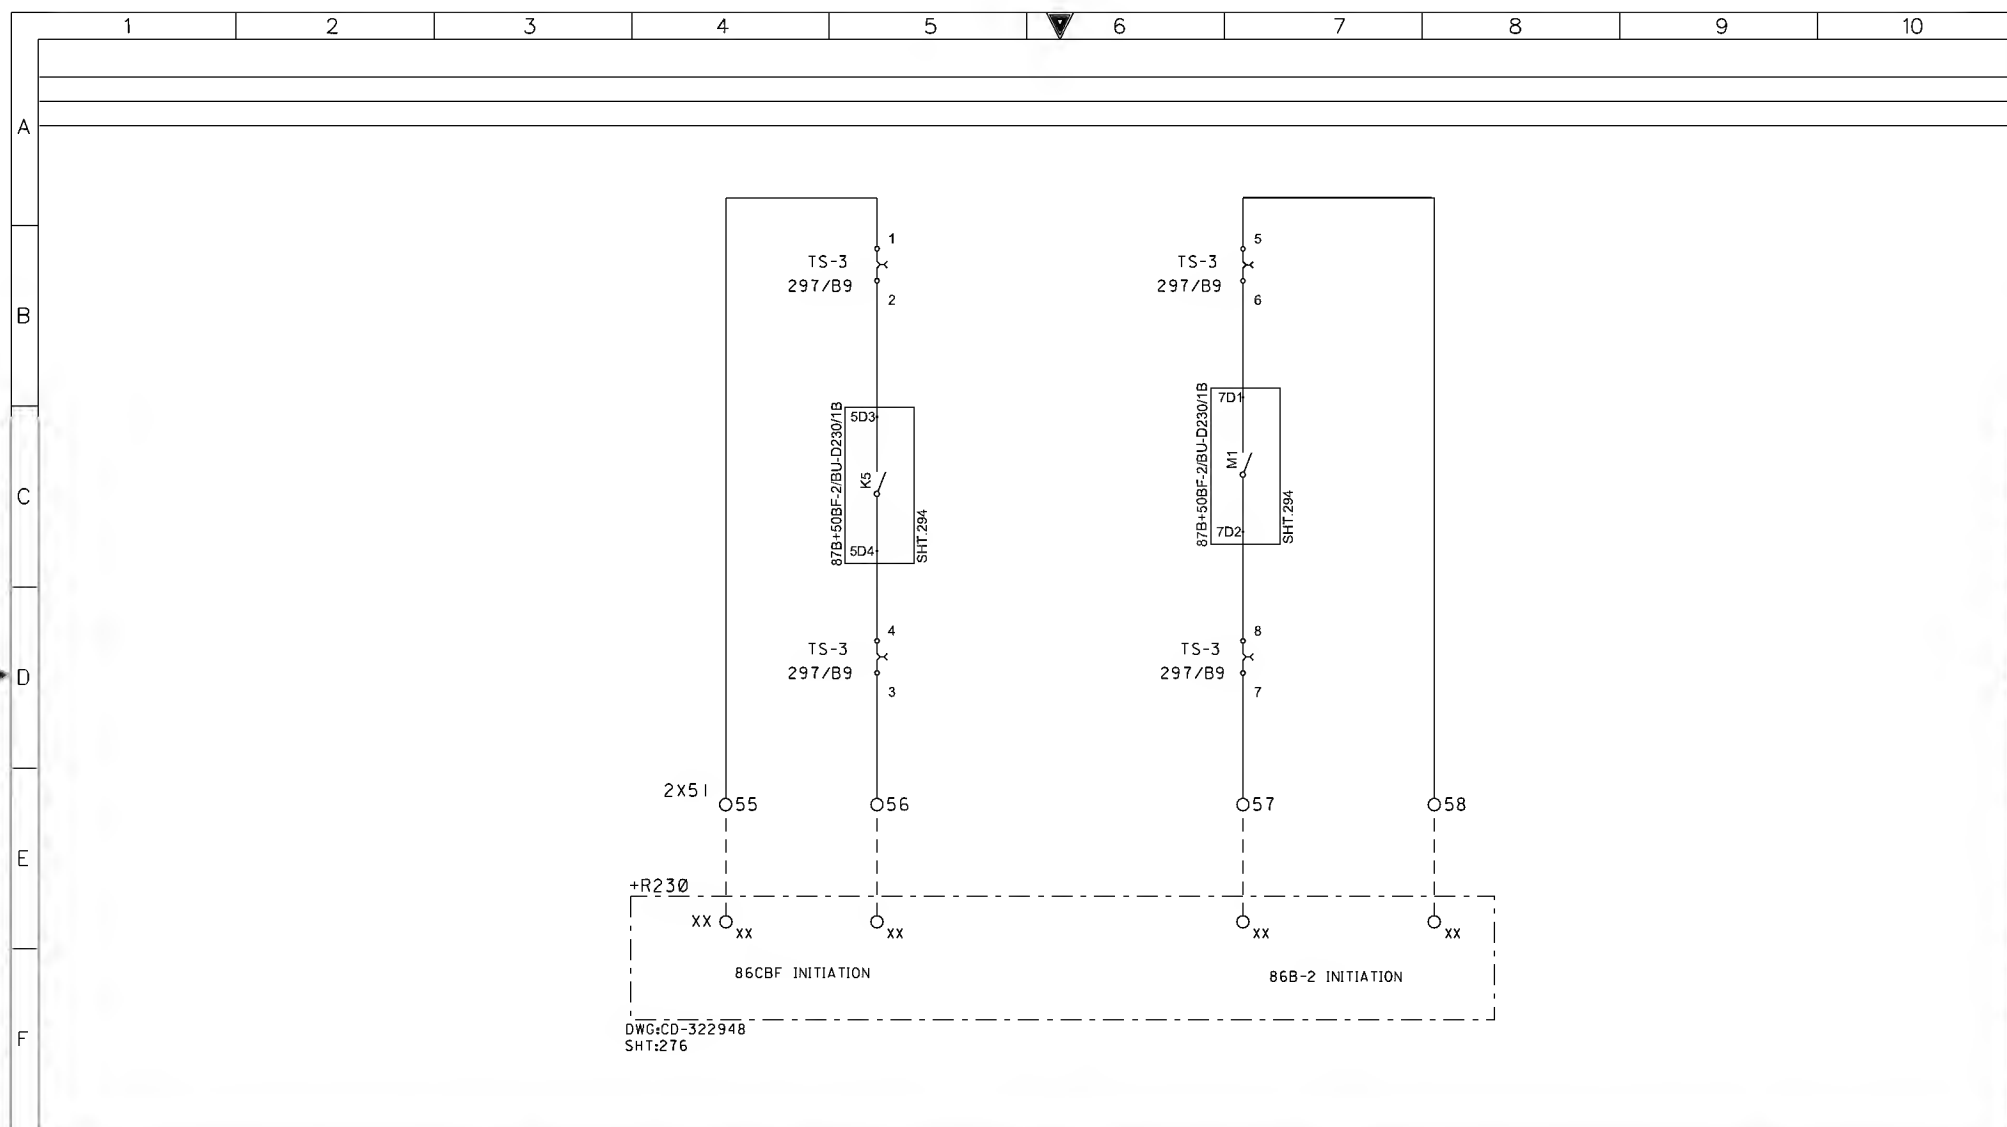

AS-BUILT BY _____ DATE _____

CONTRACT NO. 1113113/00

JOB ORDER NO. S-13656

01

13 49

FACTORY ASBUILT

00

13 05

FOR APPROVAL

REV. NO.

DATE

DESCRIPTION

DRAWN BY RIZ

CHECKED BY KVR

DATE STARTED 31.01.2013

DATE COMPLETED _____

OPRG. DEPT. CTPD

ENG. DEPT. AUT-PSAC

CBF + BUSBAR PROTEN-2 TRIP RELAY CIRCUIT -D230

132KV BUSBAR PROTN.MAIN-2 BU PANEL +BBP2-4

S/S 8709 - 132/13.8KV IN AL-KHARJ CITY

RIYADH SAUDI ARABIA

الشركة الوطنية لنقل الكهرباء



National Grid sa

INDEX

PLANT NO.

DRAWING NUMBER

SHEET NO.

SHT

CONT.

REV. NO.

-

C421


CD-323007

240

292

01

THIS DRAWING AND THE INFORMATION CONTAINED HEREIN ARE THE SOLE PROPERTY OF National Grid SA. NO REPRODUCTION IN FULL OR IN PART SHALL BE OBTAINED FROM THIS DOCUMENT WITHOUT THE WRITTEN CONSENT OF ITS OWNER.

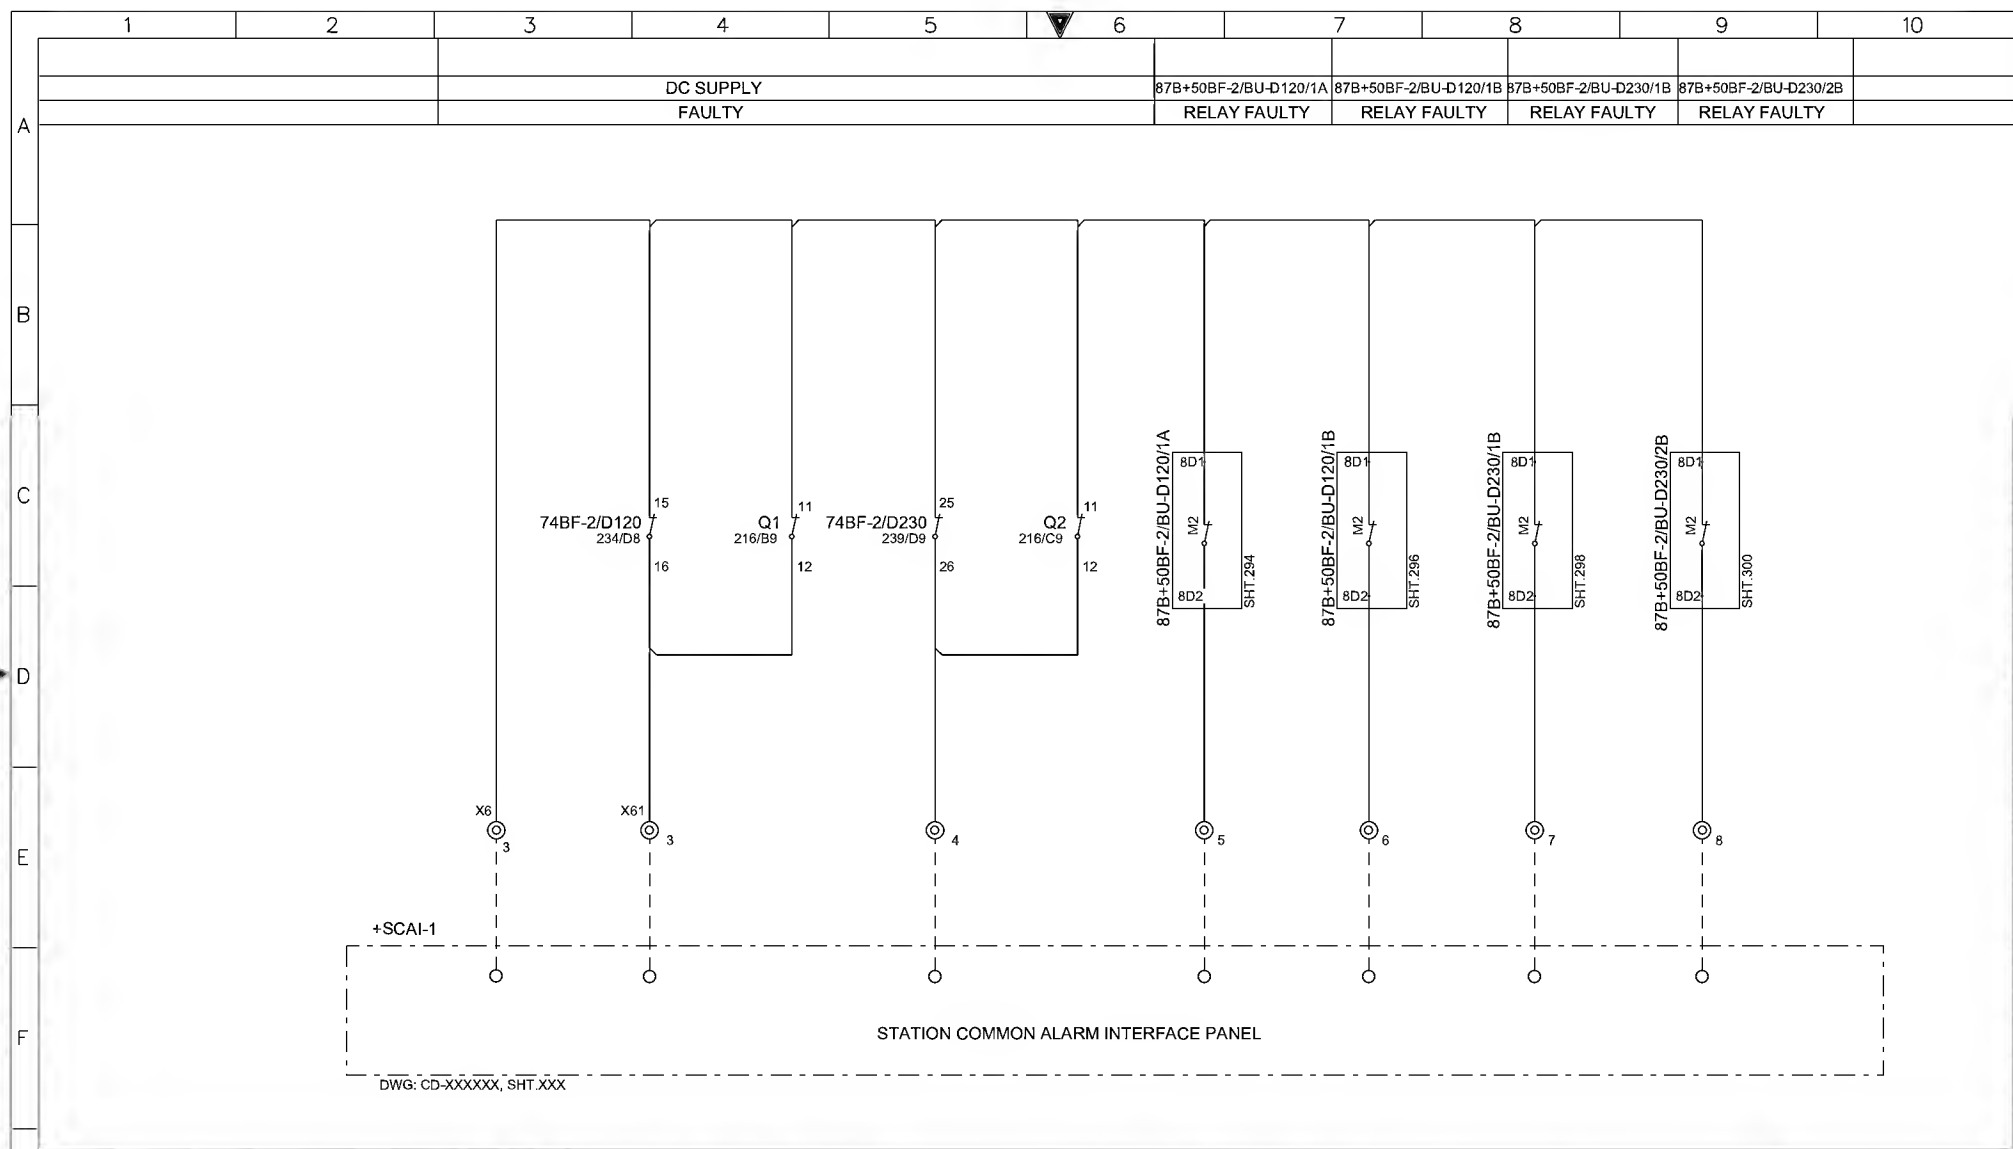

AS-BUILT BY _____ DATE _____

CONTRACT NO. 11131113/00

JOB ORDER NO. S-13656

01

13 49

FACTORY ASBUILT

00

13 05

FOR APPROVAL

REV. NO.

DATE

DESCRIPTION

DRAWN BY RIZ

CHECKED BY KVR

DATE STARTED 31.01.2013

DATE COMPLETED _____

OPRG. DEPT. CTPD

ENG. DEPT. AUT-PSAC

COMMON ALARM CIRCUITS


132KV BUSBAR PROTN.MAIN-2 BU PANEL +BBP2-4

S/S 8709 - 132/13.8KV IN AL-KHARJ CITY

RIYADH

SAUDI ARABIA

الشركة الوطنية لنقل الكهرباء



National Grid sa

INDEX

PLANT NO.

DRAWING NUMBER

SHEET NO.

SHT CONT.

REV. NO.

-

C421


CD-323007

292

293

01

THIS DRAWING AND THE INFORMATION CONTAINED HEREIN ARE THE SOLE PROPERTY OF National Grid SA. NO REPRODUCTION IN FULL OR IN PART SHALL BE OBTAINED FROM THIS DOCUMENT WITHOUT THE WRITTEN CONSENT OF ITS OWNER.

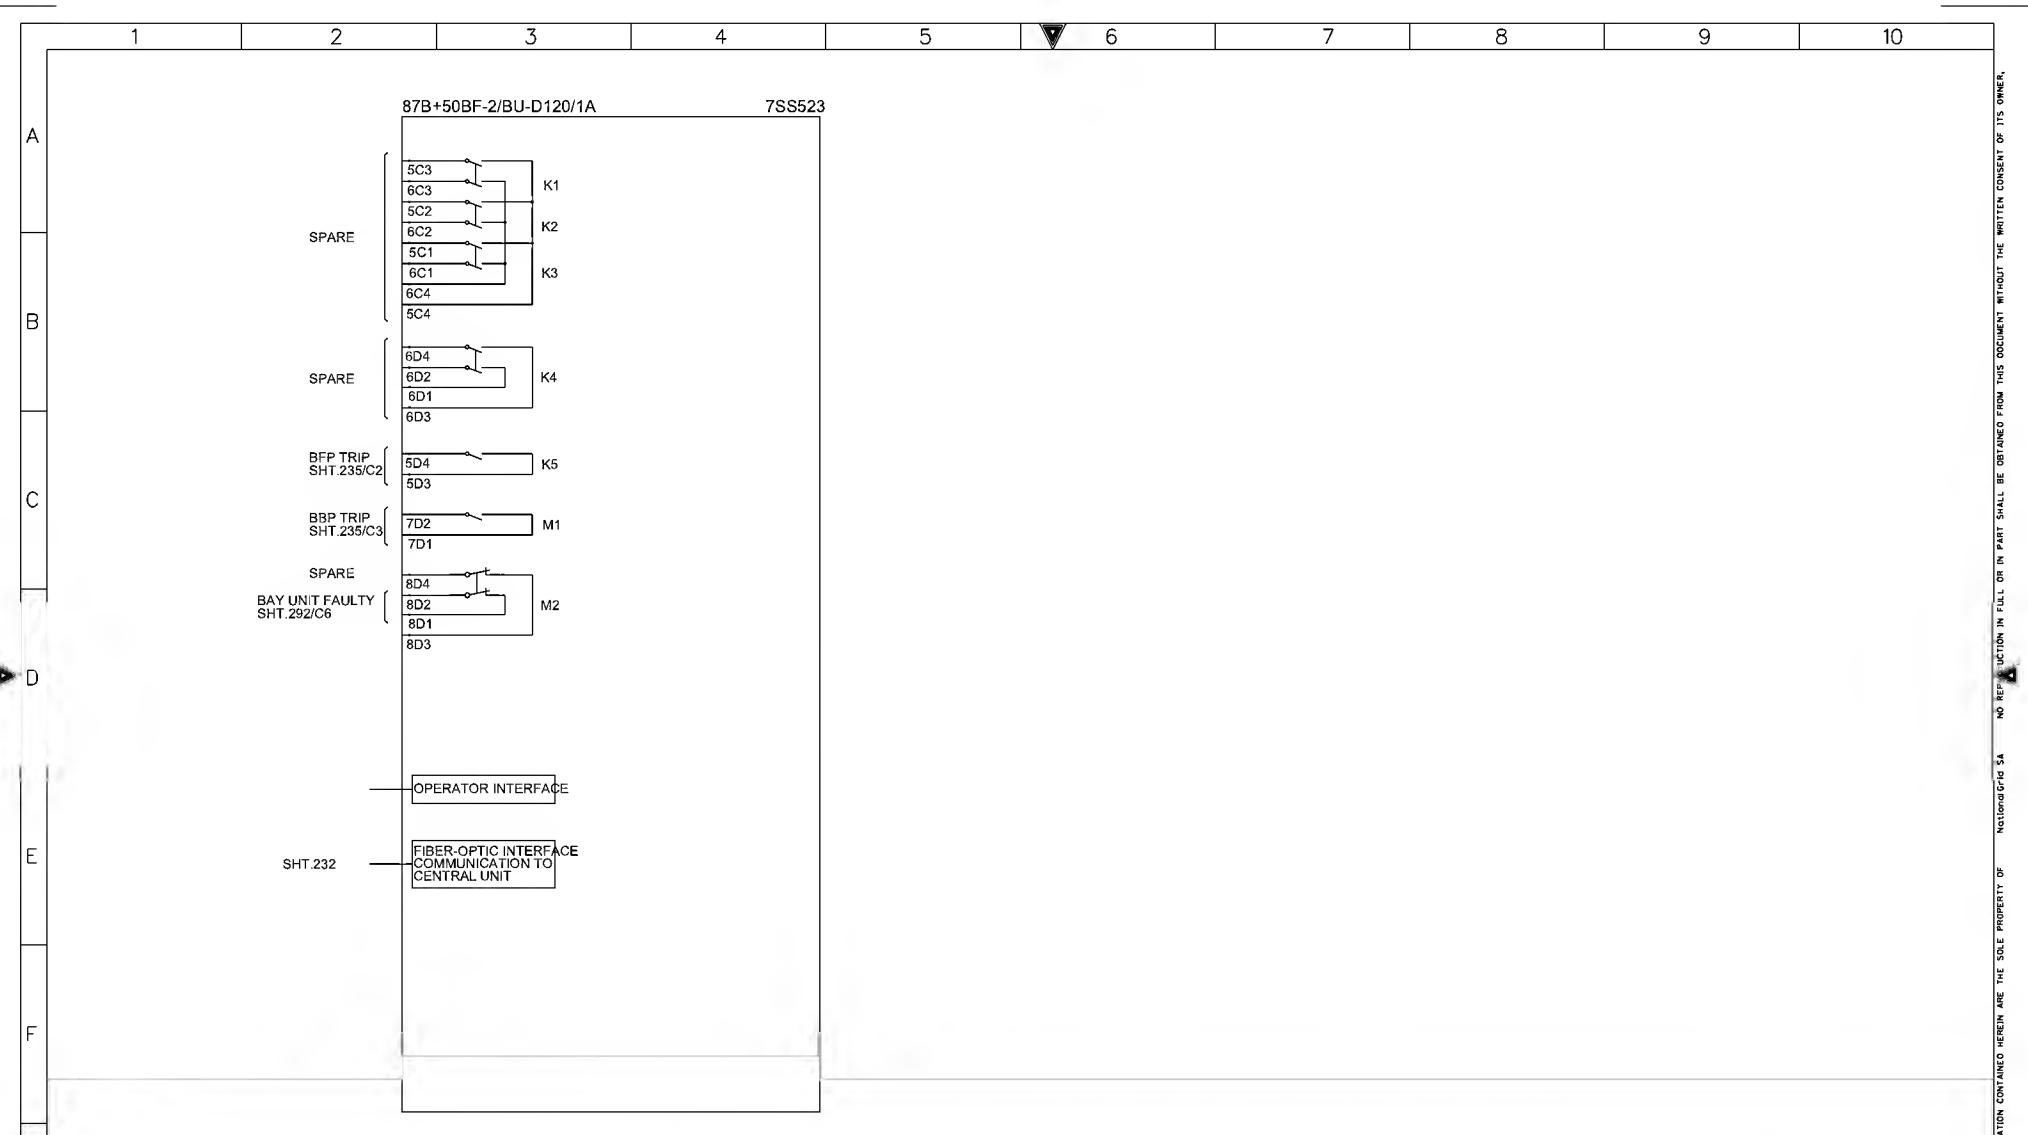


AS-BUILT BY _____		DATE _____	CONTRACT NO. 11131113/00	JOB ORDER NO. S-13656
01	13 49	FACTORY ASBUILT	DRAWN BY RIZ	CHECKED BY KVR
00	13 05	FOR APPROVAL	DATE STARTED 31.01.2013	DATE COMPLETED _____
REV. NO.	DATE	DESCRIPTION	OPRG. DEPT. CTPD	ENG. DEPT. AUT-PSAC


87B+50BF-2/BU-D120/1A INTERNAL DIAGRAM
132KV BUSBAR PROTN.MAIN-2 BU PANEL +BBP2-4
S/S 8709 - 132/13.8KV IN AL-KHARJ CITY
RIYADH SAUDI ARABIA

الشركة الوطنية لنقل الكهرباء		نقل الكهرباء	
National Grid SA		National Grid SA	
INDEX	PLANT NO.	DRAWING NUMBER	SHEET NO.
-	C421	CD-323007	SHT CONT.
			294/295
			01

THIS DRAWING AND THE INFORMATION CONTAINED HEREIN ARE THE SOLE PROPERTY OF National Grid SA. NO REPRODUCTION IN FULL OR IN PART SHALL BE OBTAINED FROM THIS DOCUMENT WITHOUT THE WRITTEN CONSENT OF ITS OWNER.

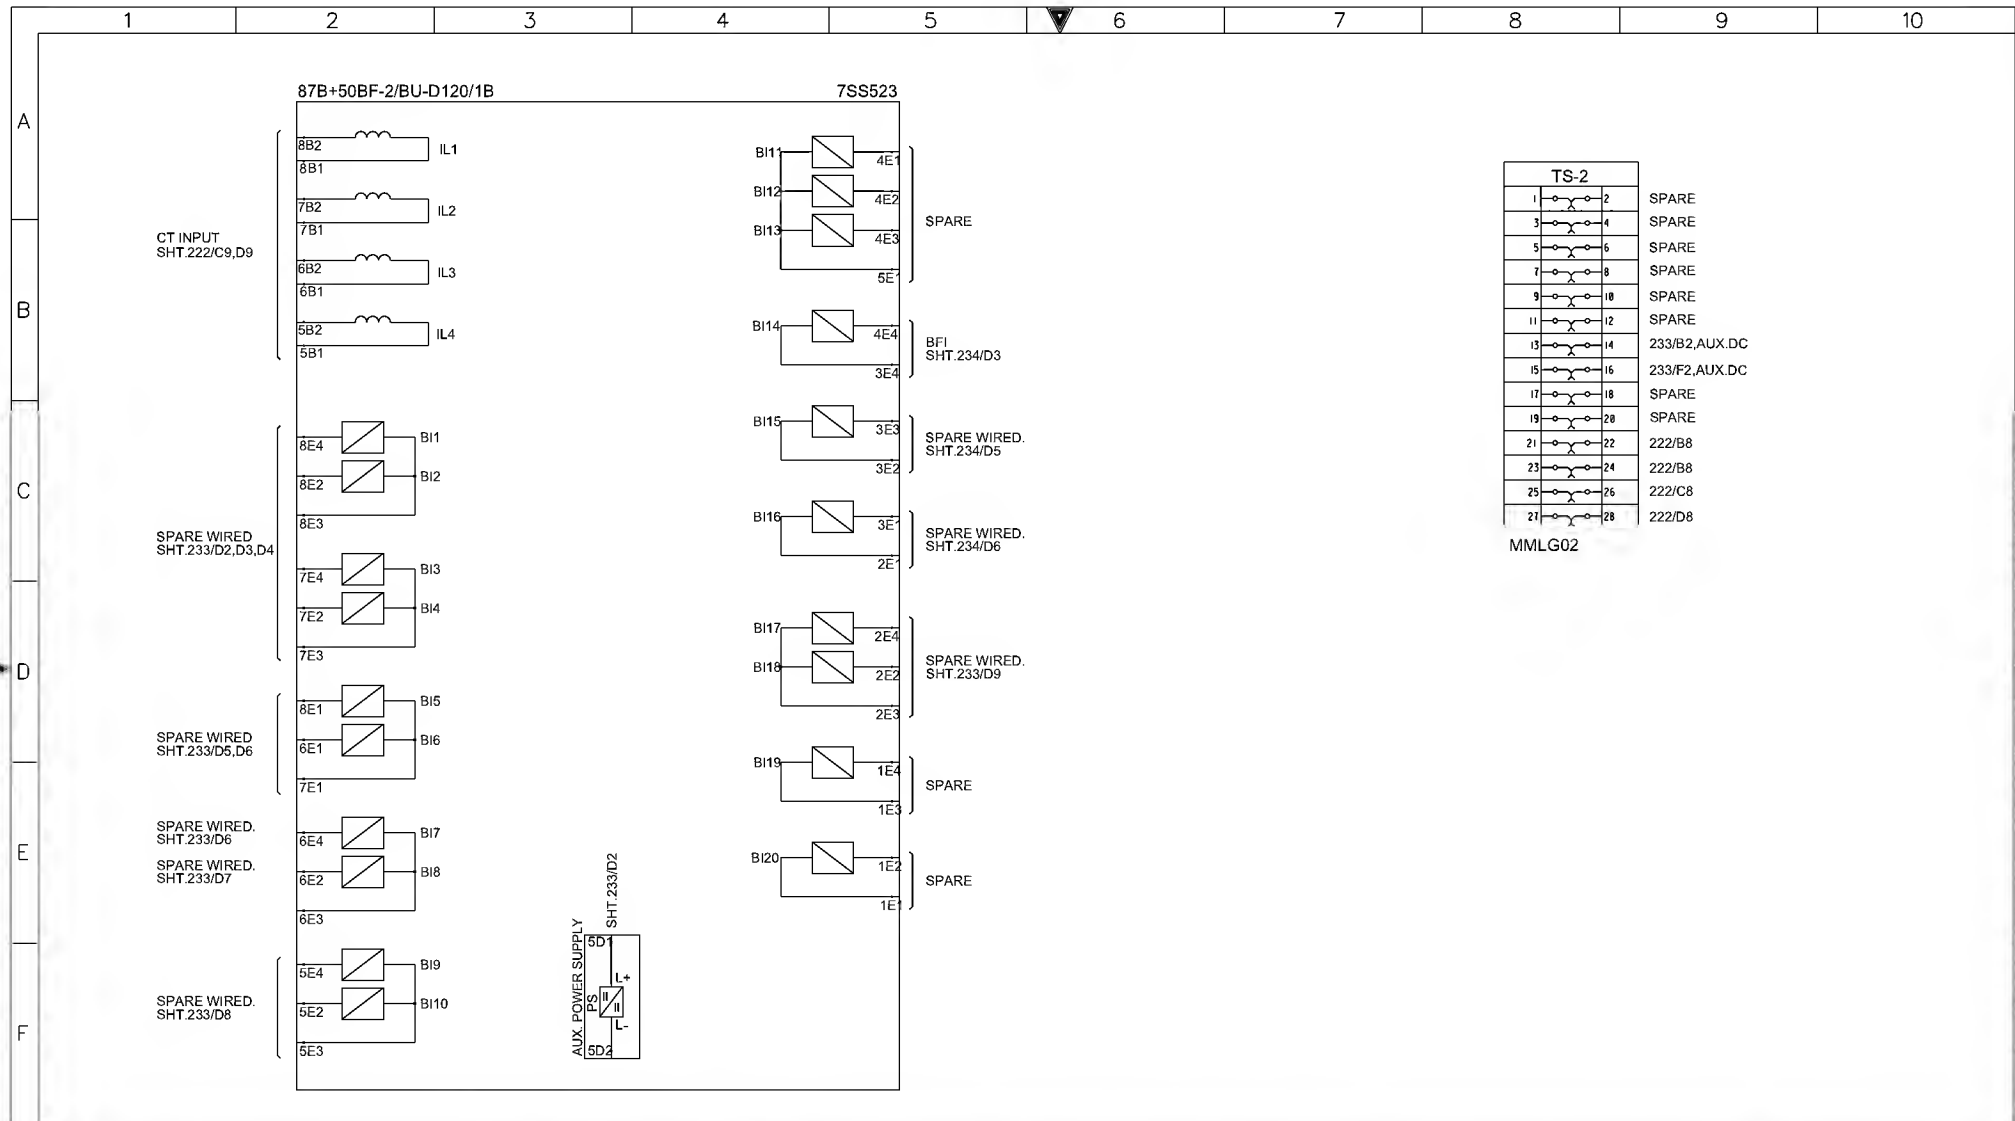

AS-BUILT BY _____ DATE _____			CONTRACT NO. 1113113/00	JOB ORDER NO. S-13656	87B+50BF-2/BU-D120/1B INTERNAL DIAGRAM	الشركة الوطنية لنقل الكهرباء National Grid sa			
01	13 49	FACTORY ASBUILT	DRAWN BY RIZ	CHECKED BY KVR	132KV BUSBAR PROTN.MAIN-2 BU PANEL +BBP2-4	INDEX	PLANT NO.	DRAWING NUMBER	SHEET NO.
00	13 05	FOR APPROVAL	DATE STARTED 31.01.2013	DATE COMPLETED	S/S 8709 - 132/13.8KV IN AL-KHARJ CITY	-	C421	CD-323007	SHT CONT
REV. NO.	DATE	DESCRIPTION	OPRG. DEPT. CTPD	ENG. DEPT. AUT-PSAC	RIYADH SAUDI ARABIA	295296 01			
						NG/D2-D (2012/01) DMS VECTOR NGD200			

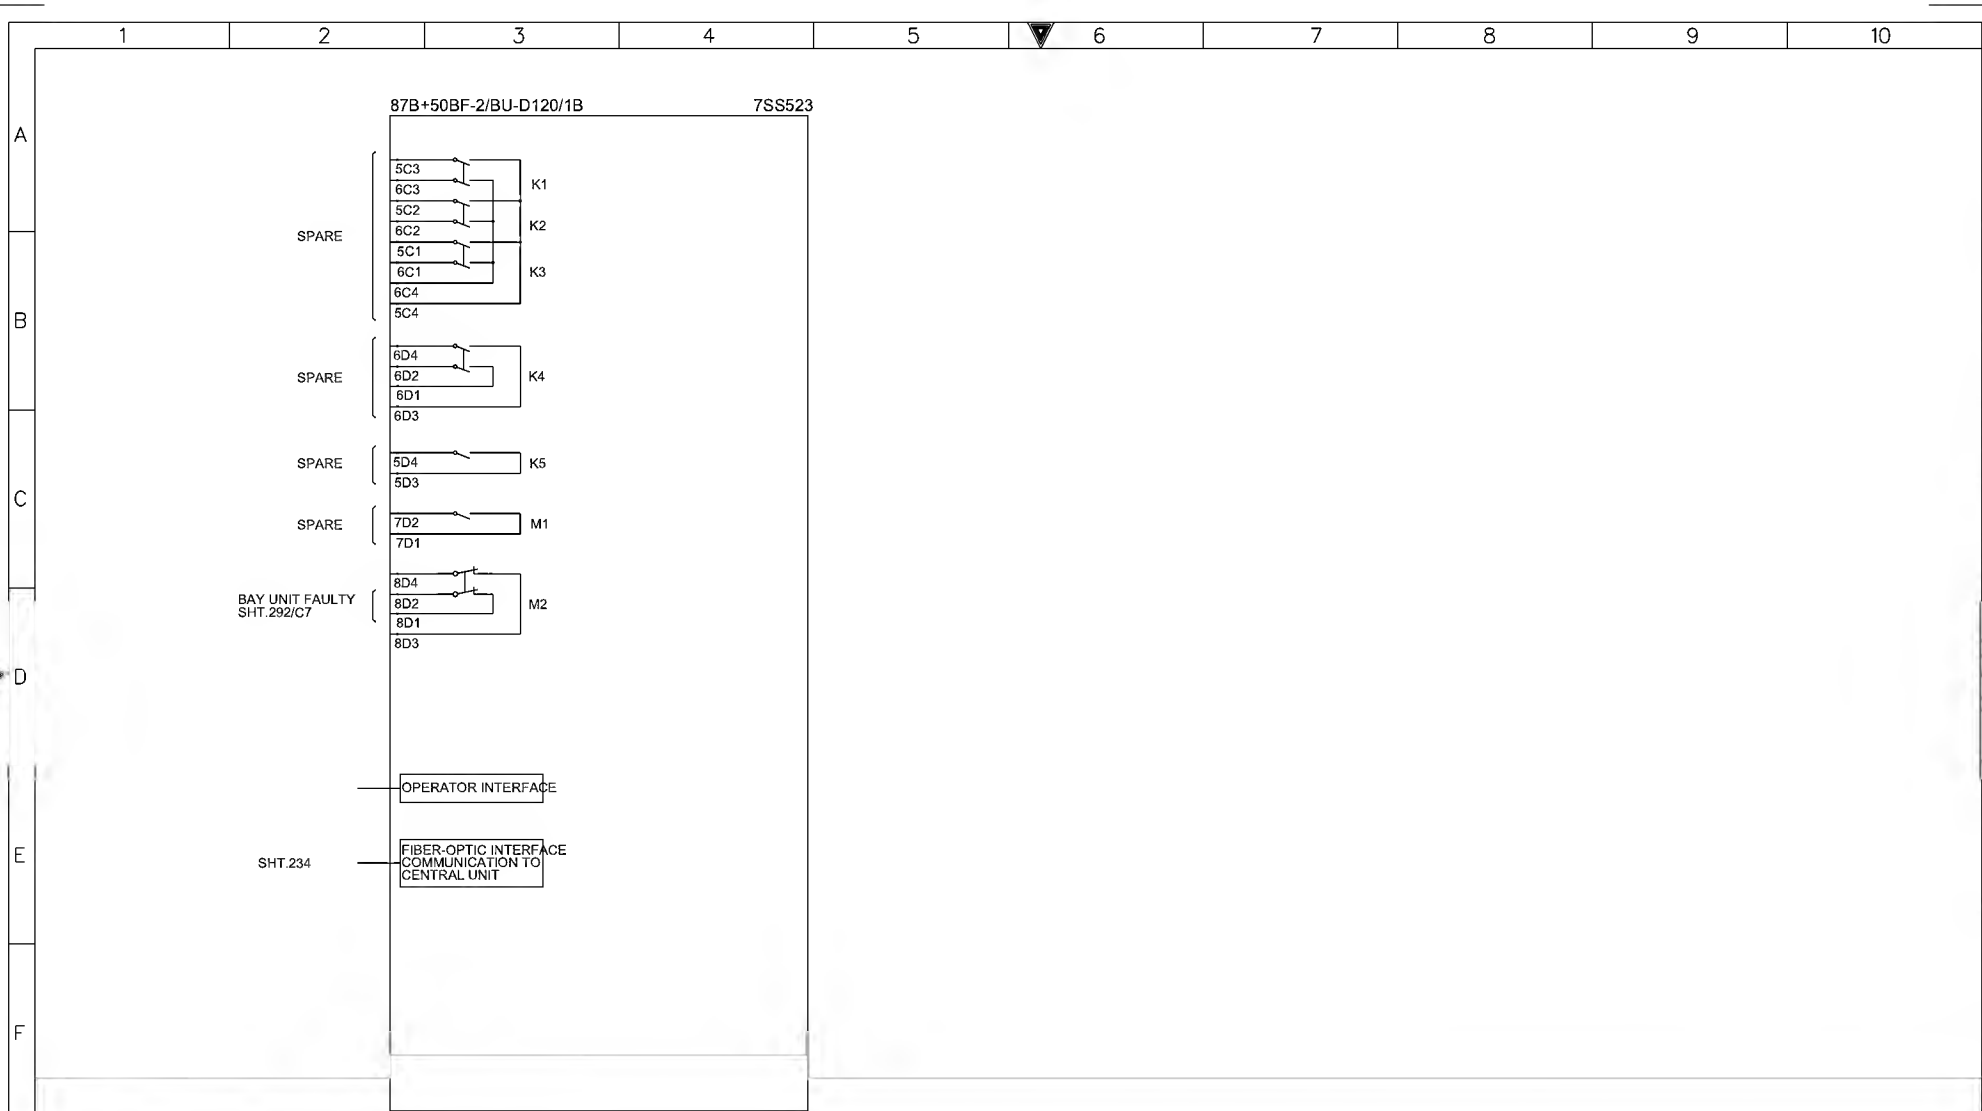

AS-BUILT BY _____ DATE _____ CONTRACT NO. 11131113/00 JOB ORDER NO. S-13656


01	13 49	FACTORY ASBUILT
00	13 05	FOR APPROVAL
REV. NO.	DATE	DESCRIPTION

DRAWN BY RIZ CHECKED BY KVR
DATE STARTED 31.01.2013 DATE COMPLETED _____
OPRG. DEPT. CTPD ENG. DEPT. AUT-PSAC

87B+50BF-2/BU-D120/1B INTERNAL DIAGRAM
132KV BUSBAR PROTN.MAIN-2 BU PANEL +BBP2-4
S/S 8709 - 132/13.8KV IN AL-KHARJ CITY
RIYADH SAUDI ARABIA

الشركة الوطنية لنقل الكهرباء		نقل الكهرباء		National Grid SA	
INDEX	PLANT NO.	DRAWING NUMBER	SHEET NO.	REV. NO.	
-	C421	CD-323007	SHT. 296/297	01	


NG/D2-0 (2012/01)
DMS VECTOR NGD200

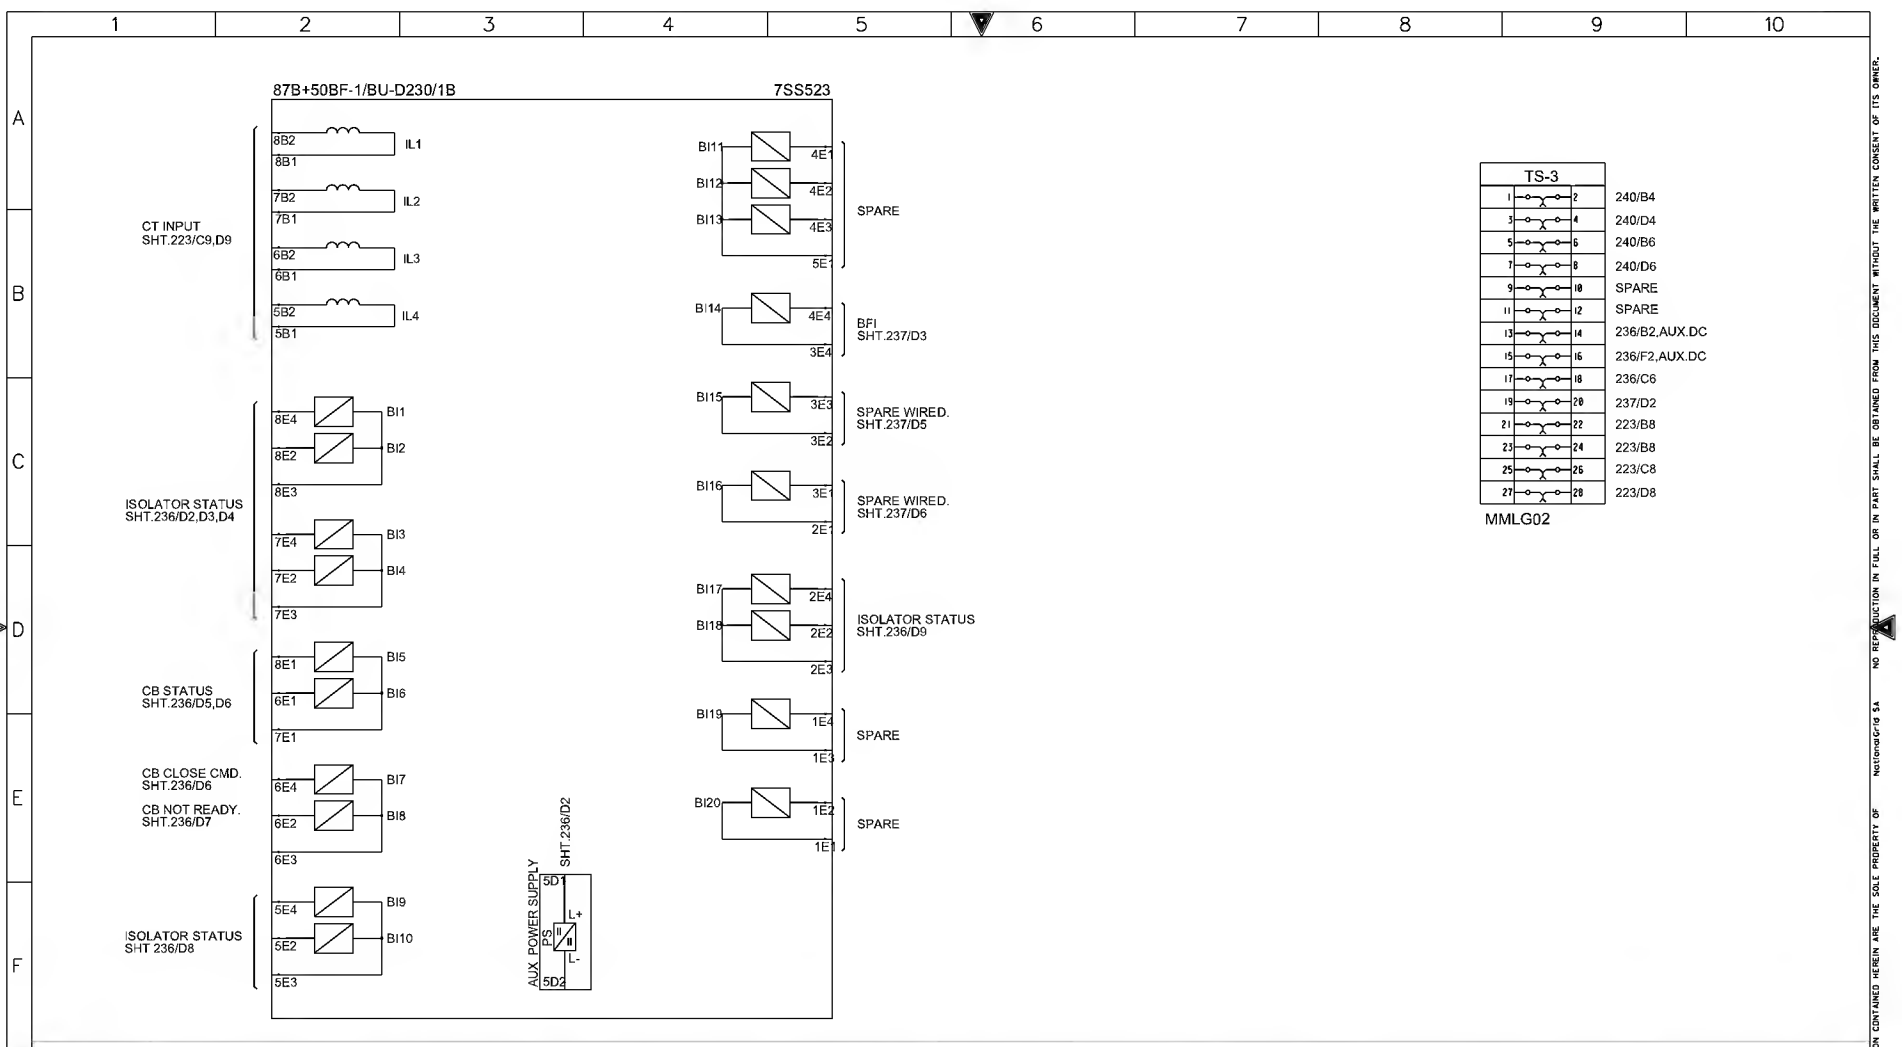

TS-3			
1	2	3	4
5	6	7	8
9	10	11	12
13	14	15	16
17	18	19	20
21	22	23	24
25	26	27	28
29	30	31	32

AS-BUILT BY		DATE	CONTRACT NO. 11131113/00	JOB ORDER NO. S-13656	87B+50BF-2/BU-D230/1A INTERNAL DIAGRAM		الشركة الوطنية لنقل الكهرباء		نقل الكهرباء	
01	13 49	FACTORY ASBUILT	DRAWN BY RIZ	CHECKED BY KVR	132KV BUSBAR PROTN.MAIN-2 BU PANEL +BBP2-4		National Grid SA			
00	13 05	FOR APPROVAL	DATE STARTED 31.01.2013	DATE COMPLETED	S/S 8709 - 132/13.8KV IN AL-KHARJ CITY		INDEX	PLANT NO.	DRAWING NUMBER	SHEET NO.
REV. NO.	DATE	DESCRIPTION	OPRG. DEPT. CTPD	ENG. DEPT. AUT-PSAC	RIYADH SAUDI ARABIA		-	C421	CD-323007	297/298
										REV. NO. 01
										NG/D2-D (2012/01)
										DMS VECTOR NCD200

NO REPRODUCTION IN FULL OR IN PART SHALL BE OBTAINED FROM THIS DOCUMENT WITHOUT THE WRITTEN CONSENT OF ITS OWNER.

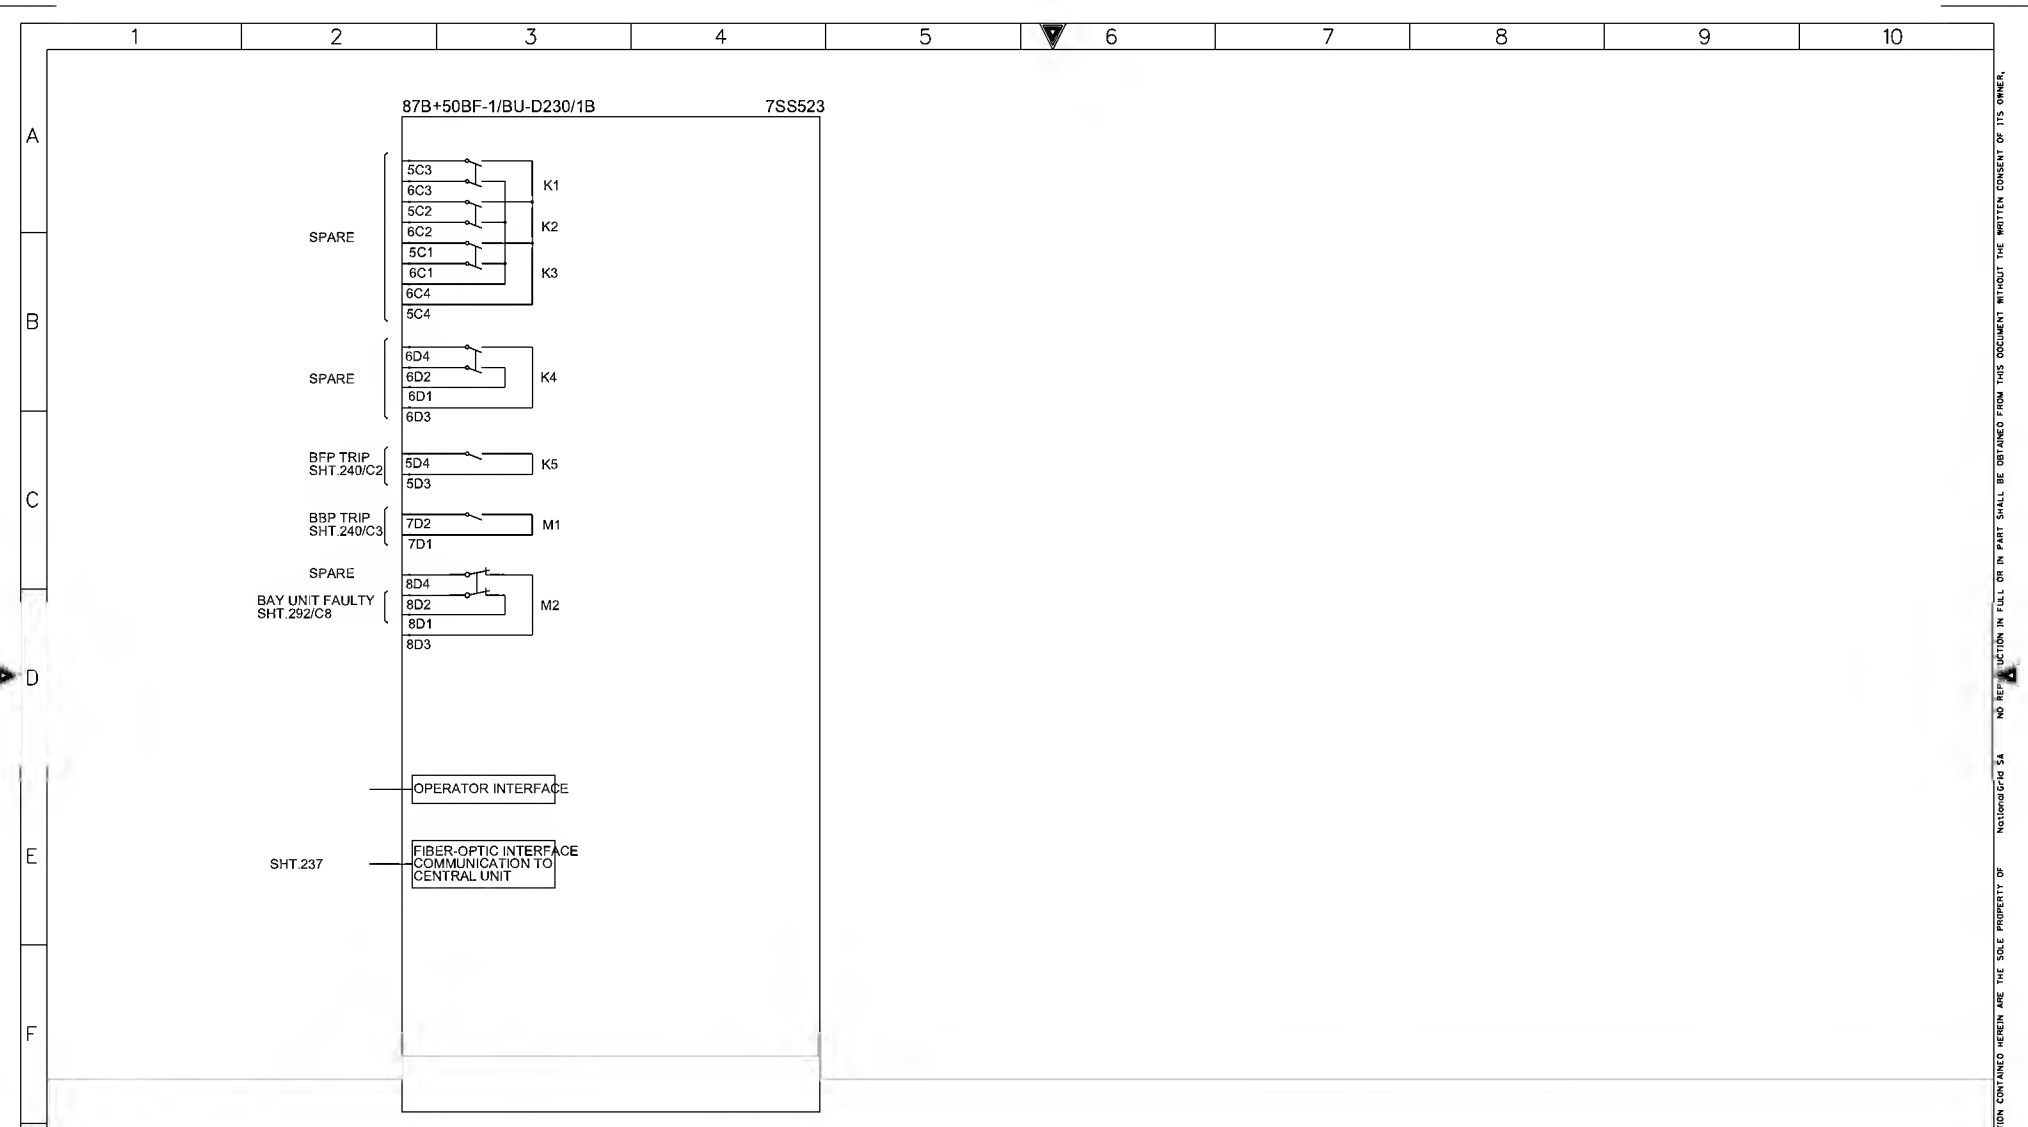

AS-BUILT BY

DATE

CONTRACT NO. 11131113/00

JOB ORDER NO. S-13656

01

13 49

FACTORY ASBUILT

00

13 05

FOR APPROVAL

REV. NO.

DATE

DESCRIPTION

DRAWN BY RIZ

CHECKED BY KVR

DATE STARTED 31.01.2013

DATE COMPLETED

OPRG. DEPT. CTPD

ENG. DEPT. AUT-PSAC


87B+50BF-2/BU-D230/1A INTERNAL DIAGRAM

132KV BUSBAR PROTN.MAIN-2 BU PANEL +BBP2-4

S/S 8709 - 132/13.8KV IN AL-KHARJ CITY

RIYADH SAUDI ARABIA

الشركة الوطنية لنقل الكهرباء



National Grid SA

INDEX	PLANT NO.	DRAWING NUMBER	SHEET NO.	REV. NO.
-	C421	CD-323007	SHT CONT 298 299	01

NG/D2-0 (2012/01)


DMS

VECTOR

NGD200


THIS DRAWING AND THE INFO

THIS DRAWING AND THE INFORMATION CONTAINED HEREIN ARE THE SOLE PROPERTY OF National Grid SA. NO REPRODUCTION IN FULL OR IN PART SHALL BE OBTAINED FROM THIS DOCUMENT WITHOUT THE WRITTEN CONSENT OF ITS OWNER.

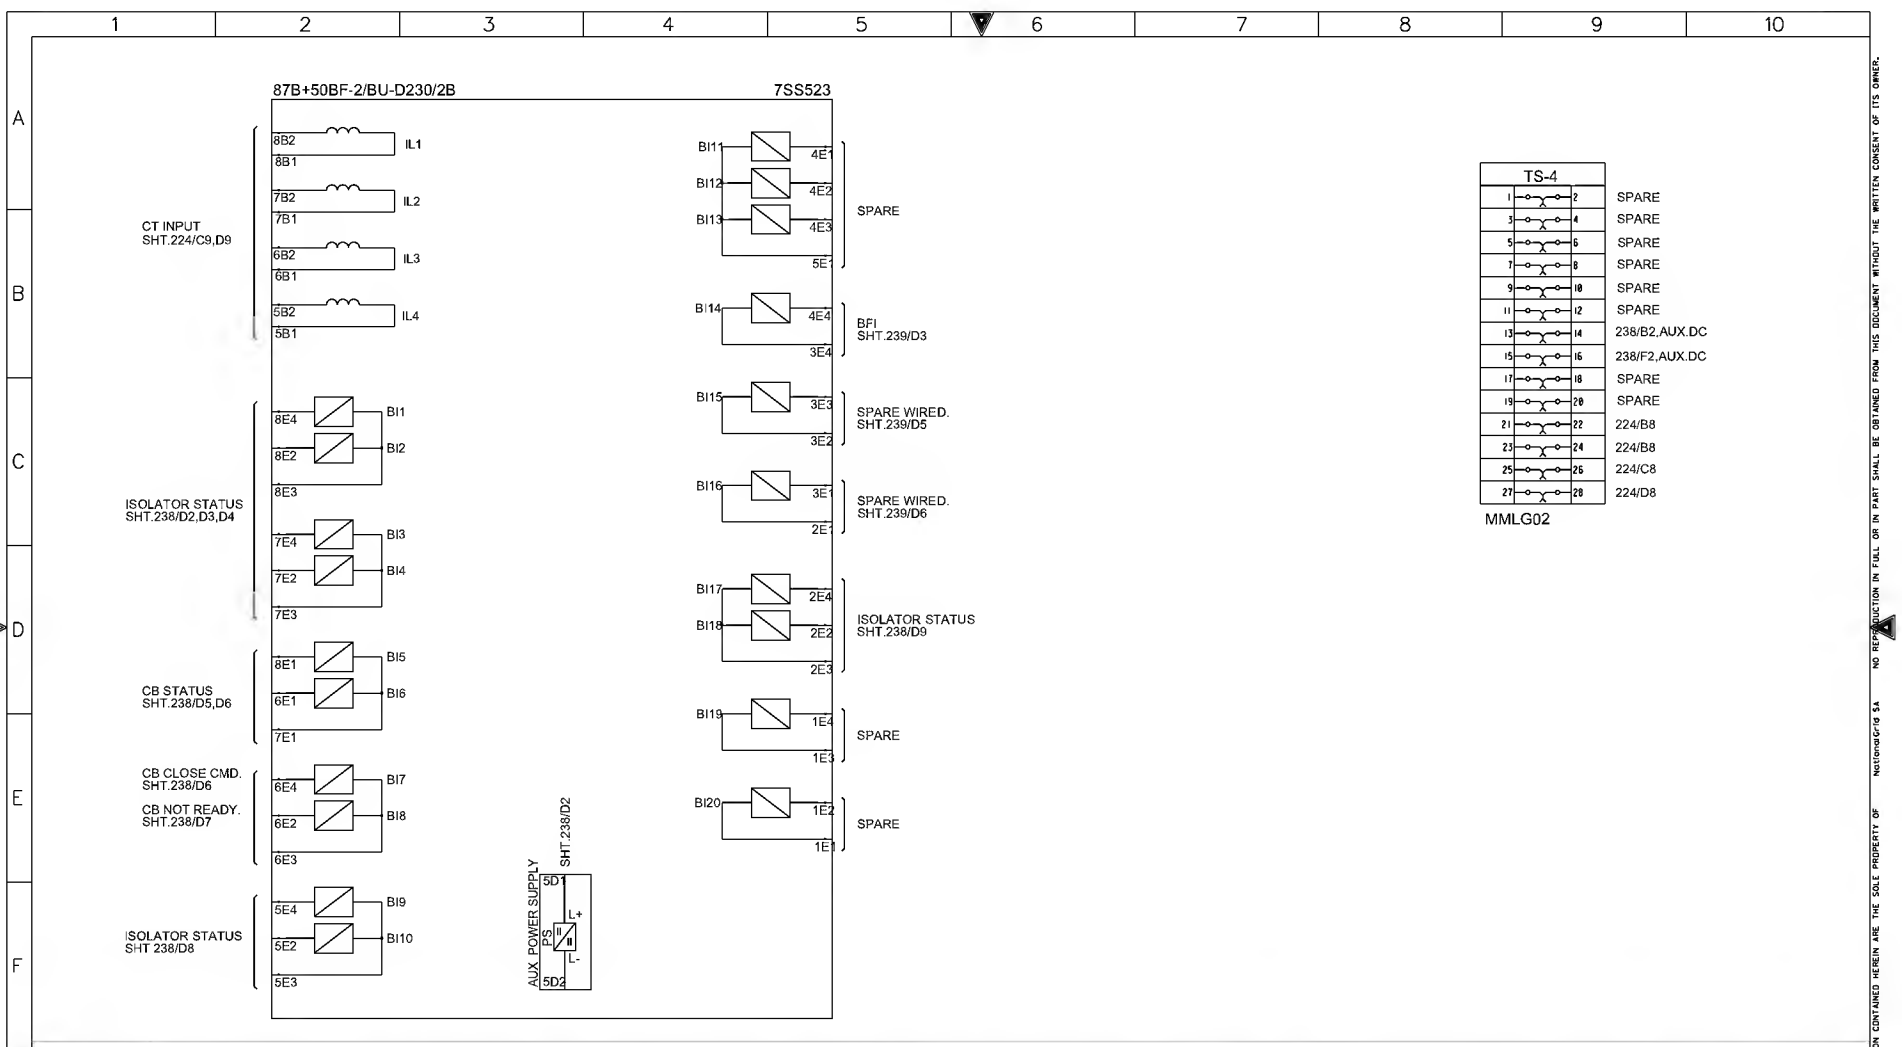

AS-BUILT BY		DATE	CONTRACT NO. 1113113/00	JOB ORDER NO. S-13656	87B+50BF-2/BU-D230/1B INTERNAL DIAGRAM		الشركة الوطنية لنقل الكهرباء		نقل الكهرباء	
01		13 49	FACTORY ASBUILT		132KV BUSBAR PROTN.MAIN-2 BU PANEL +BBP2-4		National Grid SA		SHEET NO.	
00		13 05	FOR APPROVAL		S/S 8709 - 132/13.8KV IN AL-KHARJ CITY		INDEX		PLANT NO.	
REV. NO.		DATE	DESCRIPTION		OPRG. DEPT. CTPD ENG. DEPT. AUT-PSAC		DRAWING NUMBER		SHT. CONT.	
							- C421		CD-323007	
									299/300	
									01	
									NG/D2-D (2012/01)	
									DMS VECTOR	
									NCD200	

NO REPRODUCTION IN FULL OR IN PART SHALL BE OBTAINED FROM THIS DOCUMENT WITHOUT THE WRITTEN CONSENT OF ITS OWNER.

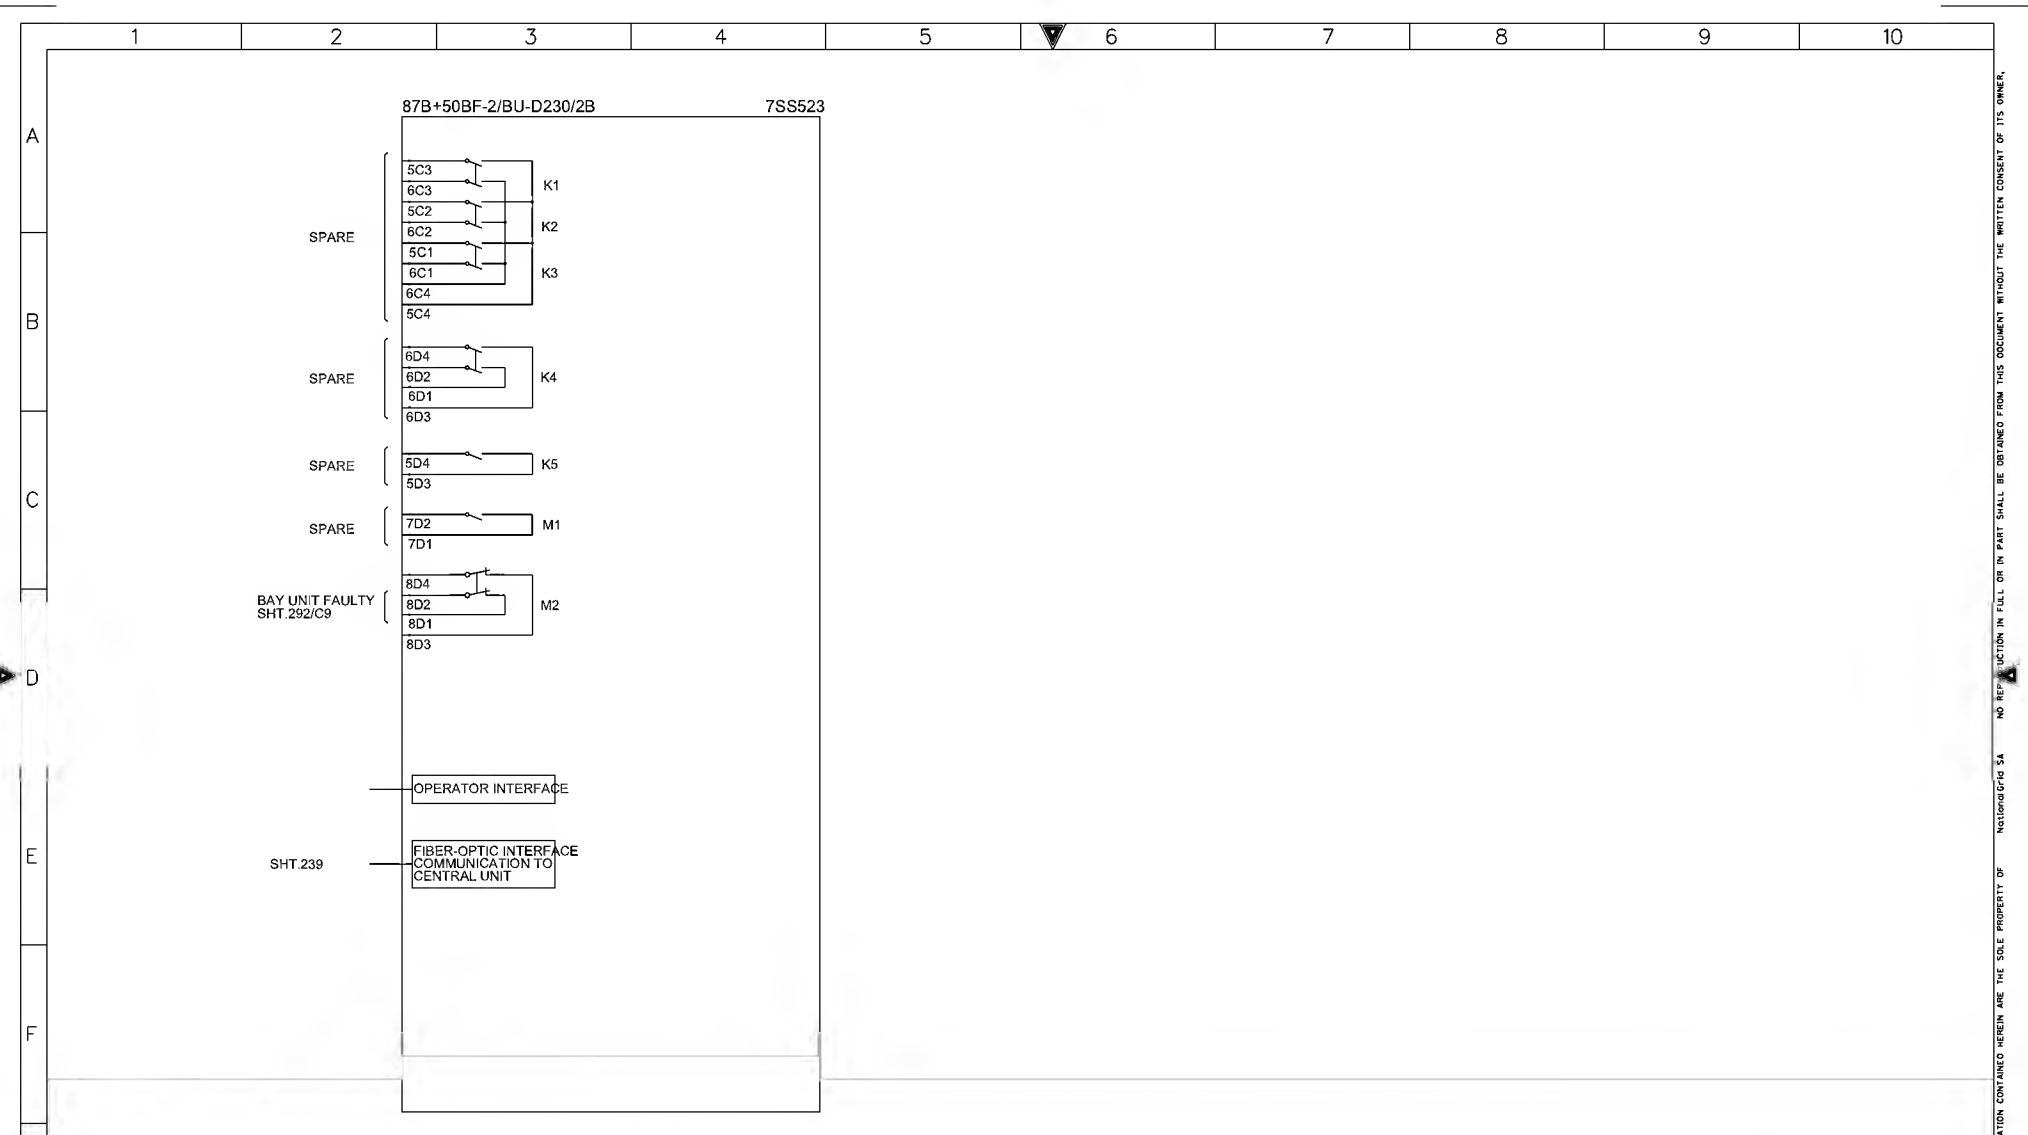

AS-BUILT BY

DATE

CONTRACT NO.

11131113/00

JOB ORDER NO.

S-13656

01

13 49

FACTORY ASBUILT

00

13 05

FOR APPROVAL

REV. NO.

DATE

DESCRIPTION

DRAWN BY

RIZ

CHECKED BY

KVR

DATE STARTED

31.01.2013

DATE COMPLETED

OPRG. DEPT.

CTPD

ENG. DEPT.

AUT-PSAC


87B+50BF-2/BU-D230/1B INTERNAL DIAGRAM

132KV BUSBAR PROTN.MAIN-2 BU PANEL +BBP2-4

S/S 8709 - 132/13.8KV IN AL-KHARJ CITY

RIYADH SAUDI ARABIA

الشركة الوطنية لنقل الكهرباء



National Grid SA

INDEX

PLANT NO.

DRAWING NUMBER

SHEET NO.

REV. NO.

-

C421

CD-323007

SHT

CONT.

300

301

01

NG/D2-0 (2012/01)

DMS


VECTOR

NGD200

THIS DRAWING AND THE INFORMATION CONTAINED HEREIN ARE THE PROPERTY OF NATIONAL GRID SA AND ARE NOT TO BE REPRODUCED OR TRANSMITTED IN ANY FORM OR BY ANY MEANS, ELECTRONIC OR MECHANICAL, INCLUDING PHOTOCOPYING, RECORDING, OR BY ANY INFORMATION STORAGE AND RETRIEVAL SYSTEM, WITHOUT THE WRITTEN PERMISSION OF NATIONAL GRID SA.

THIS DRAWING AND THE INFORMATION CONTAINED HEREIN ARE THE SOLE PROPERTY OF National Grid SA. NO REPRODUCTION IN FULL OR IN PART SHALL BE OBTAINED FROM THIS DOCUMENT WITHOUT THE WRITTEN CONSENT OF ITS OWNER.

	1	2	3	4	5	6	7	8	9	10
A	<div>REFERENCE</div> <div>221/B7</div> <div>221/B7</div> <div>221/C7</div> <div>221/C7</div> <div>221/C7</div> <div>221/C7</div> <div>221/C7</div> <div>221/D7</div> <div>221/D7</div> <div>SPARE</div> <div>222/B7</div> <div>222/B7</div> <div>222/C7</div> <div>222/C7</div> <div>222/C7</div> <div>222/C7</div> <div>222/C7</div> <div>222/C7</div> <div>222/D7</div> <div>222/D7</div> <div>SPARE</div> <div>SPARE</div> <div>SPARE</div> <div>SPARE</div> <div>SPARE</div> <div>SPARE</div>	<div>1X1 CT CKT.</div> <div>1</div> <div>2</div> <div>3</div> <div>4</div> <div>5</div> <div>6</div> <div>7</div> <div>8</div> <div>9</div> <div>10</div> <div>11</div> <div>12</div> <div>13</div> <div>14</div> <div>15</div> <div>16</div> <div>17</div> <div>18</div> <div>19</div> <div>20</div> <div>21</div> <div>22</div> <div>23</div> <div>24</div> <div>25</div>	<div>REFERENCE</div> <div>223/B7</div> <div>223/B7</div> <div>223/C7</div> <div>223/C7</div> <div>223/C7</div> <div>223/C7</div> <div>223/C7</div> <div>223/D7</div> <div>223/D7</div> <div>SPARE</div> <div>224/B7</div> <div>224/B7</div> <div>224/C7</div> <div>224/C7</div> <div>224/C7</div> AS-BUILT BY _____ DATE _____		CONTRACT NO. 11131113/00		JOB ORDER NO. S-13656		TERMINAL BLOCKS +BB2-4		 نقل الكهرباء National Grid SA	
01 13 49		FACTORY ASBUILT		DRAWN BY RIZ CHECKED BY KVR		132KV BUSBAR PROT.N.MAIN-2 BU PANEL +BBP2-4		INDEX PLANT NO. DRAWING NUMBER - C421 CD-323007	
00 13 05		FOR APPROVAL		DATE STARTED 31.01.2013 DATE COMPLETED _____		S/S 8709 - 132/13.8KV IN AL-KHARJ CITY		SHEET NO. REV. NO. 301/NIL 01	
REV. NO.	DATE	DESCRIPTION		OPRG. DEPT.	CTPD	ENG. DEPT.	AUT-PSAC	RIYADH SAUDI ARABIA NG/D2-0 (2012/01) DMS VECTOR NG0200	

THIS DRAWING AND THE INFORMATION CONTAINED HEREIN ARE THE SOLE PROPERTY OF NATIONAL GRID SA. NO REPRODUCTION OR ACTION IN FULL OR IN PART SHALL BE OBTAINED FROM THIS DOCUMENT WITHOUT THE WRITTEN CONSENT OF ITS OWNER.